

SURVEY & REMONUMENTATION

MAY 05 1997

LAND CORNER RECORDATION CERTIFICATE Filing Requirement of Act 74, Mich. P.A. 1970

For corners in **COMMISSION**

Baraga
(County)

Located In:

Corner Code #

- | | | | |
|--------------------------------------|--------------|--------------|------------|
| 1. Public Land Survey | T <u>51N</u> | R <u>33W</u> | <u>C-3</u> |
| | T _____ | R _____ | _____ |
| | T _____ | R _____ | _____ |
| | T _____ | R _____ | _____ |
| 2. Property Controlling in Section | S _____ | T _____ | R _____ |
| | S _____ | T _____ | R _____ |
| 3. Miscellaneous Property in Section | S _____ | T _____ | R _____ |
| | S _____ | T _____ | R _____ |

RECEIVED FOR RECORD THIS 30TH DAY OF JULY 1996 AT 10:30 A.M. AND RECORDED IN LIBER 4 OF LAND CORNER RECORDATION RECORDS ON PAGES 629 - 630.

Baraga County Register of Deeds
BARAGA COUNTY REGISTER OF DEEDS

Register of Deeds Stamp & File Number

4. Lot No. _____, Recorded Plat _____
5. Private Claims _____

I, Michael Mileski, in a field survey on July, 19 96, do hereby certify that under requirements of P.A. 74, Michigan P.A. of 1970, the corner points mentioned in lines 1 and 2 above were in conformance with regulations and rules therefore as required in the current manual of survey instructions of the United States Department of the Interior, Bureau of Land Management or by a decree of a Court of Law and/or that the corner points mentioned in lines 3, 4 and 5 above were in conformance with the rules of the Michigan Board of Professional Surveyors or by a Decree of a Court of Law; established, re-established, monumented, re-monumented, recovered, found as expressed below:

NOTE: Not more than 4 corners, all in the same town and range, may be recorded on this certificate.

A. Description of original monument and accessories and/or subsequent restoration:

C-3; Section Corner common to Sections 5, 6, 7, and 8, T51N, R33W;

See back of form.

APPROVED LAND CORNER
P.A. 345 OF 1990
Baraga County

7-10-96

B. Description of corner evidence found and/or method applied in restoring or reestablishing corner:


C-3; Section Corner common to Sections 5, 6, 7, and 8, T51N, R33W;

Recovered the BLM monument and all accessories as described in Part A. From this monument a decayed hemlock stump 24" in dia. and 24" tall bears N26°E a distance of 16 lks. and a probable hemlock stump hole bears approximately S54°W (record = S64°W) a distance of 11 feet to center (record = 12.54'). I left the BLM monument in place and stamped the cap "PA 345 1996". Accepted as a careful and faithful perpetuation of the position of the original corner.

C. Description of monument for corner and accessories established to perpetuate locating the position of the corner:

C-3; Section Corner common to Sections 5, 6, 7, and 8, T51N, R33W;

See back of form.

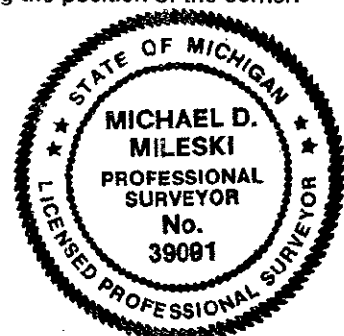

Signed by Michael Mileski

Date 13 July 1996

Surveyor's Michigan License No. 39091

FORM APPROVED BY MICHIGAN STATE BOARD OF PROFESSIONAL SURVEYORS, JAN. 28, 1971
REVISED MAY 14, 1975
REVISED JAN., 1983

A. Description of original monument and accessories and/or subsequent restoration:

C-3; Section Corner common to Sections 5, 6, 7, and 8, T51N, R33W;

Originally established during U.S. Survey conducted by Harvey Mellen, D.S. in 1845 and monumented with a yellow birch post witnessed by a

Hemlock 20 N26°E 16 lks. and a Hemlock 16 S64°W 19 lks.

During the course of a survey conducted by Stephen Douglas of the Bureau of Land Management from 10 May 1984 to 10 November 1984 and approved 23 September 1985, this corner was remonumented with a 2½" x 30" aluminum pipe with cap stamped as to location from the remains of both U.S. bearing trees. Specifically the BLM field notes state that from the monument " a decayed hemlock stump, 24 ins. diam., bears N26°E, 16 lks. dist., with no mks. visible " and " a hemlock stump hole, bears S64°W, 19 lks. dist.". The BLM noted the following new bearing trees:

Maple 8 N21°E 45½ lks. (30.03')

Found red maple presently alive and 13" in dia. having a partially open lower blaze with scribing visible.

Set 7" spike W/side Measured N19°E 30.03'

Double Hemlock 15 S17°E 124 lks. (81.84')

Presently alive and 20" in dia. having an open lower blaze with scribing visible. These hemlocks are joined at the trunk at ground level. The east one is marked.

Set 7" spike E/side Measured S20°E 81.28'

Maple 10 S77°W 47½ lks. (31.35')

Found red maple presently alive and 16" in dia. having a partially open lower blaze with scribing visible.

Set 7" spike S/side Measured S73°W 31.35'

Maple 7 N67°W 53½ lks. (35.31')

Found red maple presently alive and 9" in dia. having a healed lower blaze.

Set 7" spike N/side Measured N72°W 35.31'

C. Description of monument for corner and accessories established to perpetuate locating the position:

C-3; Section Corner common to Sections 5, 6, 7, and 8, T51N, R33W;

Found a 2½" dia. aluminum pipe with 3" aluminum cap appropriately stamped as to location as set by the BLM in 1984. The following new bearing trees were established by the BLM in 1984.

Set 7" spike	W/side	13" Red Maple	N19°E	30.03'
Set 7" spike	E/side	20" Double Hemlock	S20°E	81.28'
Set 7" spike	S/side	16" Red Maple	S73°W	31.35'
Set 7" spike	N/side	9" Red Maple	N72°W	35.31'
		Location Post	North	1.0'

The above BLM new bearing trees were painted red.

SURVEY &
REMONUMENTATION

MAY 05 1997

COMMISSION