

# SURVEY & REMONUMENTATION

AUG 22 1995

## BARRY COUNTY REMONUMENTATION

COMMISSION

### LAND CORNER RECORDATION CERTIFICATE

Filing Requirement of Act 74, Mich. P.A. 1970

STATE OF MICHIGAN  
COUNTY OF BARRY  
RECEIVED FOR RECORD

MAR 20 10 55 AM '95

Sandy Schindelmarer

REGISTER OF DEEDS

For corners in

**BARRY**

(County)

Located In:

Corner Code **≠**

1. Public Land Survey  
**1/4 CORNER COMMON TO  
SECTIONS 8 & 17  
ASSYRIA TOWNSHIP**

T **1N** R **7W**

**D-5**

T R

T R

T R

2. Property Controlling  
in Section

S T R

S T R

3. Miscellaneous  
Property in Sec.

S T R

S T R

4. Lot No. , Recorded Plat

5. Private Claims

**BRIAN REYNOLDS**

**22 FEBRUARY**

**95**

I, **BRIAN REYNOLDS**, in a field survey on **22 FEBRUARY**, 19**95**, do hereby certify that under requirements of P.A. 74, Michigan P.A. of 1970, the corner points mentioned in lines 1 and 2 above were in conformance with regulations and rules therefore as required in the current manual of survey instructions of the United States Department of the Interior, Bureau of Land Management or by a decree of a Court of Law and/or that the corner points mentioned in lines 3, 4 and 5 above were in conformance with the rules of the Michigan Board of Land Surveyors or by a Decree of a Court of Law; established, re-established, monumented, re-monumented, recovered, found as expressed below:

**NOTE: Not more than 4 corners, all in the same town and range, may be recorded on this certificate.**


A. Description of original monument and accessories and/or subsequent restoration:

**GENERAL LAND OFFICE: MUSGROVE EVANS, D.S., 1826 (R7W, P.37) "WEST CORRECTED 40.05"**  
**TAM. 4 S.70E. 12 Do. N.44W. 11 links**

**COUNTY SURVEYOR RECORDS: PRATT 1881 (ASSYRIA F.B., P.6) & PRATT FEB, 15 1890 (ASSYRIA F.B., P.13)**  
**STAKE & STONE" B. CHERRY 10 S.64 3/4W. 61**

**NO OTHER RECORDED HISTORICAL INFORMATION AVAILABLE FOR THIS CORNER**

	A	B	C	D	E	F	G	H	I	J	K	L	M
2	6	5	4	3	2	1							
3													
4	7	8	9	10	11	12							
5													
6	13	17	16	15	14	13							
7													
8	19	20	21	22	23	24							
9													
10	30	29	28	27	26	25							
11													
12	31	32	33	34	35	36							
13													

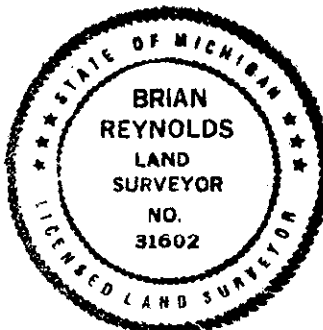

ACT 345 BARRY COUNTY REMONUMENTATION  
APPROVED BY PEER REVIEW AT A MEETING HELD ON

6 Dec. '94

BRIAN REYNOLDS

BR

COUNTY SURVEYOR

D. Description of monument for corner and accessories established to perpetuate locating the position of the corner:

**SET STANDARD BARRY COUNTY REMONUMENTATION MONUMENT (3/4"X36"W/ALUMINUM CAP)**  
**SET 40d NAIL W/PLASTIC TAG IN THE NORTH SIDE NORTH TRUNK OF A 16" TRIPLE CHERRY S65°E 109.93'**  
**SET 40d NAIL W/PLASTIC TAG IN THE EAST SIDE OF A 36" OAK N11°E 16.86'**  
**SET 40d NAIL W/PLASTIC TAG IN THE EAST SIDE OF A 27" OAK N10°W 19.16'**  
**SET 40d NAIL W/PLASTIC TAG IN THE ROOT ON THE SOUTH SIDE OF A 22" CHERRY N60°W 39.77'**  
**SET 40d NAIL W/PLASTIC TAG IN THE BASE ON THE EAST SIDE OF AN 18" TWIN OAK S17°W 74.03'**  
**CORNER LIES 10' +/- WEST OF THE CENTERLINE OF A GRAVEL ROAD SOUTH**  
**1' +/- SOUTH OF THE CENTERLINE OF AN EAST-WEST GRAVEL ROAD**

igned by

Date

MARCH 17, 1995

urveyor's Michigan License No.

31602