

DEC 7 4 26 PM '93

Sandy Schondelmayer  
REGISTER OF DEEDS

002129

BARRY COUNTY REMONUMENTATION  
LAND CORNER RECORDATION CERTIFICATE  
Filing Requirement of Act 74, Mich. P.A. 1970

For corners in

Barry

(County)

Located In:

Corner Code ##

1. Public Land Survey

T 1N R 7W

G-7

T R

T R

T R

T R

2. Property Controlling  
in Section

S T R

S T R

3. Miscellaneous

S T R

Property in Sec.

S T R

4. Lot No. Recorded Plat

5. Private Claims

Register of Deeds Stamp & File Number

I, Daniel M. Ryan, in a field survey on September 8, 19 93,  
do hereby certify that under requirements of P.A. 74, Michigan P.A. of 1970, the corner points mentioned  
in lines 1 and 2 above were in conformance with regulations and rules therefore as required in the  
current manual of survey instructions of the United States Department of the Interior, Bureau of Land  
Management or by a decree of a Court of Law and/or that the corner points mentioned in lines 3, 4 and 5  
above were in conformance with the rules of the Michigan Board of Land Surveyors or by a Decree of a  
Court of Law; established, re-established, monumented, re-monumented, recovered, found as  
expressed below:

NOTE: Not more than 4 corners, all in the same town and range, may be recorded  
on this certificate.

A. Description of original monument and accessories and/or subsequent restoration:

GL0: 12" White Oak, N45½°E, 15 links

County Surveyor: Brick, stone & sleigh shoe  
School house S43½°E, 1.37 feet  
Grocery, S72°W, 49 feet  
(Assyria field book series #2, Pg 4)

D. Hooth, 4/16/64:

R.R. spike in centerline M-66

Powerpole, N33°W, 56.51 feet

Powerpole, S34°E, 52.36 feet

Northeast corner porch, S70°W, 30.15  
feet

C. Pike, 3/16/73:

Monument box

7 feet, more or less, South of centerline of Tasker  
Road

70 feet East of centerline of M-66

B. Description of corner evidence found and/or method applied in restoring or reestablishing corner:

Found ½" iron in Monument box.

70', more or less, East of centerline of M-66.

7 feet, more or less, South of centerline of road East

C. Description of monument for corner and accessories established to perpetuate locating the position of the corner:

Found ½" iron in monument box. Replaced with Barry County remonumentation iron spike.

Chiseled "X" with drill hole on top of concrete curb, N46°W, 38.20 feet.

Chiseled "X" with drill hole on top of concrete curb, S40°W, 37.63 feet.


Nail with spotter in Power pole, S34°E, 52.36 feet.

P.K. in West side of Power pole, S20°E, 98.13 feet.

SURVEY &  
REMONUMENTATION

APR 05 1994

COMMISSION

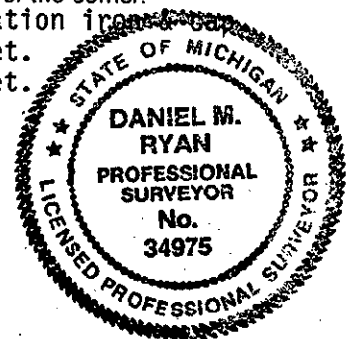

Signed by

*Daniel M. Ryan*

Date

September 8, 1993

Surveyor's Michigan License No.

34975