

MAR 9 2000

SECTION

LAND CORNER RECORDATION CERTIFICATE
Filing Requirement of Act 74, Mich. P.A. 1970

LIBER 2 PAGE 266

STATE OF MICHIGAN
BENZIE COUNTY
RECORDED5 JAN 2000 3:27:51 PM
MICHELLE R. GRAY
REGISTER OF DEEDS
PAGES ONE

For corners in

<u>Benzie</u>	Located In:	Corner Code #
(County)		
1. Public Land Survey	T <u>26N</u> R <u>13W</u>	<u>F-5(Inland)</u>
	T <u> </u> R <u> </u>	<u> </u>
	T <u> </u> R <u> </u>	<u> </u>
	T <u> </u> R <u> </u>	<u> </u>
2. Property Controlling	S <u> </u> T <u> </u> R <u> </u>	<u> </u>
in Section	S <u> </u> T <u> </u> R <u> </u>	<u> </u>
3. Miscellaneous	S <u> </u> T <u> </u> R <u> </u>	<u> </u>
Property in Sec.	S <u> </u> T <u> </u> R <u> </u>	<u> </u>

Register of Deeds Stamp & File
Number4. Lot No. , Recorded Plat 5. Private Claims

I, David T. Rowe, in a field survey on October 20, 1999 do hereby state that under requirements of P.A. 74, Michigan P.A. of 1970, the corner points mentioned in lines 1 and 2 above were in conformance with regulations and rules therefore as required in the current manual of survey instructions of the United States Department of the Interior, Bureau of Land Management or by a decree of a Court of Law and/or that the corner points mentioned in lines 3, 4 and 5 above were in conformance with the rules of the Michigan Board of Land Surveyors or by a Decree of a Court of Law; established, re-established, monumented, recovered, found as expressed below:

NOTE: Not more than 2 corners, all in the same town and range, may be recorded on this certificate.

	A	B	C	D	E	F	G	H	I	J	K	L	M
1													
2	6			5		4		3		2		1	
3													
4	7			8		9		10		11		12	
5													
6	18			17		16		15		14		13	
7													
8	19			20		21		22		23		24	
9													
10	30			29		28		27		26		25	
11													
12	31			32		33		34		35		36	
13													

A. Description of original monument and accessories and/or subsequent restoration:

F-5: ¼ Corner Common to Sections 9 and 16:

G.L.O. Notes: 1839 12" Hemlock ¼ Section Post, 13" Sugar N20°W 271ks.

County Records: 1880 D. Holden, Surveyors Record I, page 120, Set from original bearings.

1900 C. Tuller, Surveyors Book I, page 8 Fd. Stake in center of road in line of fences running N-S.

1976 G. DelaMater, Recorded surveys L.I, page 462, Fd. Iron.

1984 G. DeleMater, L. I, page 170, Set P.K. nail. S10°W. 87.2' 6" R. Pine, N45°W 114.6' P. Pole, N60°E 110.4' Gasline markers.

1994 M. Harris, L. I, page 312, Fd. P.K. nail. P. Pole N41°W 107.17', 20" Maple S70°E 140.45', 6" Cherry N11°E 73.56', 14" Norway S26°W 102.73.

B. Description of corner evidence found and/or method applied in restoring or reestablishing corner:

F-5: ¼ Corner Common to Sections 9 and 16:

1999 Fd. P.K. nail with DNR washer in Centerline US-31. Old fence standing to North and old fallen fence to South. The Benzie County Peer Group accepted the P.K. nail and washer by the DNR as being the best evidence of a locally accepted corner.

C. Description of monument for corner and accessories established to perpetuate locating the position of the corner:

F-5: ¼ Corner Common to Sections 9 and 16:

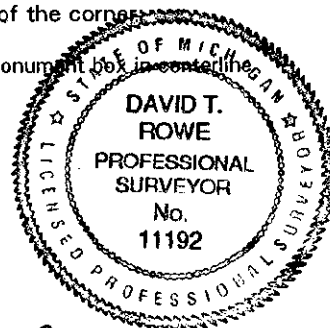
P.K. nail with DNR washer replaced with ¼" i. d. galvanized 36" long iron pipe with a stamped brass cap in a monument box in centerline US-31.

Witnesses: S14°W 87.13' Fd. Spike E. Face Blazed 14" R. Pine 5.5' above ground.

S10°E 72.52' Fd. #25850 capped rerod

N43°W 107.11' Fd. P.K. nail NE Face P. Pole

S70°E 140.50' Fd. D.H. nail NE Face 20" Maple

Ratified by Peer Group
In accordance with P.A. 845Chairman Date 11/9/1999Signed by David T. RoweDate Dec 17, 1999Surveyor's Michigan License No. 11192