


LAND CORNER RECORDATION CERTIFICATE
Filing Requirement of Act 74, Mich. PA 1970

Form with fields for Benzie (County), Located In, Corner Code #, and numbered sections 1-5 for survey details.

Register of Deeds Stamp & File Number

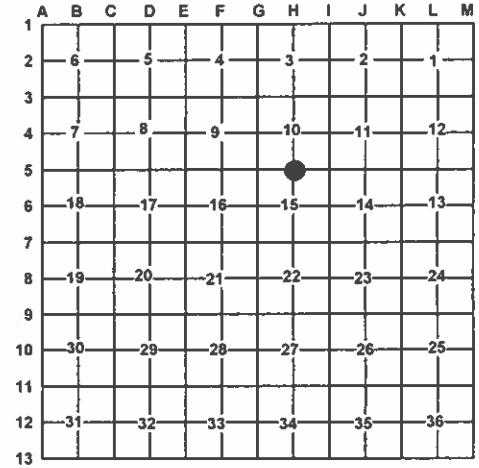

NOTE: Not more than 2 corners, all in the same town and range, may be recorded on this certificate.

A. Description of original monument and accessories and/or subsequent restoration:

- H5 - 1839 - Alvin & Austin Burt - Set 1/4 Post
1) Sugar 12" N4°W 37 L.
2) Beech 13" S4°W 29
- 1992 - LCRC L. 1, p. 287 - R. Max Harris (PS #25845) -
1/2" iron rod found -
3) 12.8' S. of centerline US-31
4) 6" Maple S50°E 45.6'
5) 12" Tw. Maple S3°E 34.25'
6) 8" Maple S72°W 82.30' Ev. of Old Fence lines.
- 1999 - LCRC L. 2, p. 259 - D. T. Rowe (PS #11192) - Fd. Broken
off boat spike 13'S of Centerline US-31. Old fallen fence to south.

- Replaced Boat Spike with 3/4" I.D. x 36" long iron pipe with stamped Brass Cap in Monument Box 13' S. of centerline US-31.
4) S3°E 34.33' Fd. Spike E. Face blazed twin 10" Maple;
7) S52°E 61.10' Fd. Spike SW Face 12" Maple;
6) S73°W 82.43' Fd. Spike N. face Blazed 10" Maple;
8) N5°E 65.50' Fd. Spike W. face 12" J. Pine
- 2000 - MDOT US-31 Road Plans Control Section M-10032; Job #48733A. Survey Centerline of US-31 - N1°22'28"E 4.139m [13.58'] of 'H5'.

B. Description of corner evidence found and/or method applied in restoring or re-establishing corner:

- H5 - 1/4 Corner common to Sections 10 & 15, T26N, R14W - Found 3" Benzie Co. Remon. Brass Cap in Monument Box. Condition of witnesses as follows: #1, 2, 4, 5, 6, & 7 are gone. Wit. #8 is dead and fallen. Based on ties to MDOT alignment points from the 2000 road plans the intersection of the survey centerline for US-31 & N-S 1/4 line is 13.52' (13.58' - MDOT) north of 'H5'. It appears that road widening destroyed the BT's S. of the road. Found fence remain running south from 'H5'. Brass Cap in monument box was previously accepted by remonumentation peer group as the best available evidence of a locally accepted corner.

C. Description of monument for corner and accessories established to perpetuate locating the position of the corner:

- H5 - 3" Brass Cap in Monument Box
S1°20'W 75.47' to set N & T in E. side 26" Sugar Maple
S53°29'E 94.67' to set N & T in NE side Power Pole
N24°45'W 74.29' to set Spike and Tag in W. side 19" W. Pine
N1°13'E 88.99' to Fd. 1/2" CIR #25845 on line and add Blue Composite Post with loc. Tag.
Note: Bearing and distance is to end of nails and spike in BT's.



Signed by: [Signature]
Surveyor's Michigan License No.: 39088

Date: 5/10/2016