

RAVISED BY THE BERRIEN COUNTY  
SURVEY PEER GROUP AS THE  
OFFICIAL CORNER UNDER MICHIGAN  
PUBLIC ACT 845 OF 1990

**BERRIEN COUNTY REMONUMENTATION  
LAND CORNER RECORDATION CERTIFICATE**

7-06-00 Filing Requirement of Act 74, Mich. P.A. 1970  
For corners in

BERRIEN Located In: \_\_\_\_\_ Corner Code # M-6  
(County)

- |                                       |   |            |   |             |            |
|---------------------------------------|---|------------|---|-------------|------------|
| 1. Public Land Survey                 | T | <u>4 S</u> | R | <u>17 W</u> | <u>M-6</u> |
|                                       | T | _____      | R | _____       | _____      |
|                                       | T | _____      | R | _____       | _____      |
|                                       | T | _____      | R | _____       | _____      |
| 2. Property Controlling<br>in Section | S | _____      | T | _____       | _____      |
|                                       | S | _____      | T | _____       | _____      |
| 3. Miscellaneous<br>Property in Sec.  | S | _____      | T | _____       | _____      |
|                                       | S | _____      | T | _____       | _____      |
4. Lot No. \_\_\_\_\_, Recorded Plat \_\_\_\_\_ 5.  
Private Claims \_\_\_\_\_

10/20/00 111#4516 A66  
CORNER \$7.00  
10/20/00 111#4516 A66  
STATE REMON FEE \$2.00

Register of Deeds Stamp & File  
Number

I, V.J. Strebs, in  
a field survey on SEPT 21 \_\_\_\_\_,  
2000 do hereby state that under  
requirements of P.A. 74, Michigan P.A. of 1970,  
the corner points mentioned in lines 1 and 2  
above were in conformance with regulations  
and rules therefore as required in the current  
manual of survey instructions of the United  
States Department of the Interior, Bureau of  
Land Management or by a decree of a Court of  
Law and /or that the corner points mentioned  
in lines 3, 4 and 5 above were in conformance  
with the rules of the Michigan Board of Land  
Surveyors or by a Decree of a Court of Law;  
established, re-established, monumented,  
recovered, found as expressed below:

	A	B	C	D	E	F	G	H	I	J	K	L	M
1													
2	6		5		4		3		2		1		
3													
4	7		8		9		10		11		12		
5													
6	18		17		16		15		14		13		
7													
8	19		20		21		22		23		24		
9													
10	30		29		28		27		26		25		
11													
12	31		32		33		34		35		36		
13													

NOTE: Not more than 2 corners, all in the same town and range, may be recorded  
on this certificate.


A. Description of original monument and accessories and/or subsequent restoration:

- 1827 WILLIAM BROOKFIELD, D.S.  
SET 1/2 MILE POST  
7" BEECH S52<sup>1</sup>/3<sup>0</sup> W 39 LINKS  
8" BEECH N34<sup>0</sup> W 67 LINKS
- 1873 THOMAS LOVE, COUNTY SURVEYOR  
FOUND QUARTER POST FROM ORIGINAL WITNESSES AND SET STONE
- 1920 - 1950 J.H. DEWEY  
STONE  
12" APPLE N 42<sup>0</sup> E 62.1'  
12" ELM S 12<sup>0</sup> E 99.7'  
P.P. N 83<sup>0</sup> W 39.1'
- 1948 - 1965 BERRIEN COUNTY ROAD COMMISSION  
IRON  
6" PEACH N 80<sup>0</sup> E 33.5'  
T.P. S 50<sup>0</sup> E 40.1'  
P.P. N 85<sup>0</sup> W 39.1'
- 1994 JOHN HUNT  
FOUND RAILROAD SPIKE  
1/2" REBAR W/CAP #23513 WEST 33.00'  
1/2" REBAR WEST 1/4 COR. SECTION 18-4-16 NORTH 29.48'  
PK NAIL IN PP N 70<sup>0</sup> W 39.40'  
PK NAIL IN 5" CHERRY N 50<sup>0</sup> E 42.86'  
NAIL & TAG IN 4" CHERRY N 80<sup>0</sup> E 33.23'  
PK NAIL IN 5" CHERRY S 63<sup>0</sup> E 36.38'

**SURVEY &  
REMONUMENTATION**

**JAN 31 2001**

**SECTION**

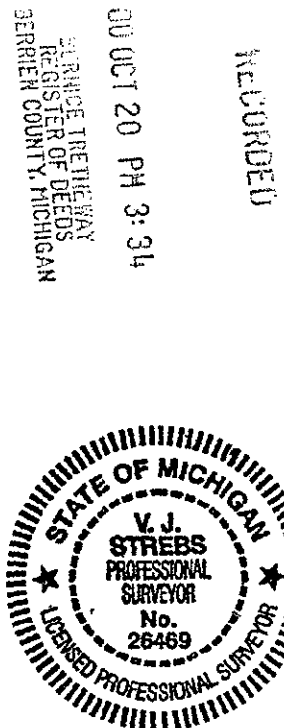

B. Description of corner evidence found and/or method applied in restoring or reestablishing corner:

FOUND RAILROAD SPIKE

C. Description of monument for corner and accessories established to perpetuate locating the position of the corner:

RESET RAILROAD SPIKE WITH 1" X 3" IRON PIPE STAMPED 26469, 2000 IN MONUMENT BOX  
WITNESS TAG IN P.P. N 75<sup>0</sup> W 39.34'  
WITNESS TAG IN 6" PEACH N 50<sup>0</sup> E 42.81'  
WITNESS TAG IN 6" PEACH S 35<sup>0</sup> E 49.74'  
WEST 1/4 COR. SECTION 18-4-16 NORTH 29.40'  
AND IS ACCEPTED AS A CAREFUL AND FAITHFUL PERPETUATION OF THE POSITION OF THE ORIGINAL CORNER.

Signed by V.J. Strebs  
Surveyor's Michigan License No. 26469

Date 19 OCT 2000