

ATIFIED BY THE BERRIEN COUNTY
SURVEY PEER GROUP AS THE
OFFICIAL CORNER UNDER MICHIGAN
PUBLIC ACT 345 OF 1990

BERRIEN COUNTY REMONUMENTATION
LAND CORNER RECORDATION CERTIFICATE
Filing Requirement of Act 74, Mich. P.A. 1970

RECORDED

DEC 26 11 46 AM '96

Bernice Trachway
REGISTER OF DEEDS
BERRIEN COUNTY MICHIGAN

For corners in
BERRIEN
(County)

Located In:

Corner Code #

- | | | |
|---------------------------------------|------------|-----|
| 1. Public Land Survey | T 6S R 18W | I13 |
| | T R | |
| | T R | |
| | T R | |
| | T R | |
| 2. Property Controlling
in Section | S T R | |
| | S T R | |
| 3. Miscellaneous
Property in Sec. | S T R | |
| | S T R | |

12/26/96 111#9871 A99
CORNER \$9.00
12/26/96 111#9871 A99
Register of Deeds Stamp & File Number
STATE REMON FEE \$2.00

4. Lot No. _____, Recorded Plat _____
5. Private Claims _____

I, CHARLES W. BARGER, in a field survey on DECEMBER, 1996,
do hereby certify that under requirements of P.A. 74, Michigan P.A. of 1970, the corner points mentioned
in lines 1 and 2 above were in conformance with regulations and rules therefore as required in the
current manual of survey instructions of the United States Department of the Interior, Bureau of Land
Management or by a decree of a Court of Law and/or that the corner points mentioned in lines 3, 4 and 5
above were in conformance with the rules of the Michigan Board of Land Surveyors or by a Decree of a
Court of Law; established, re-established, monumented, re-monumented, recovered, found as
expressed below:

**NOTE: Not more than 4 corners, all in the same town and range, may be recorded
on this certificate.**

A. Description of original monument and accessories and/or subsequent restoration:

MARCH 1827 SET POST COMMON TO SECTIONS 34 & 35
W. BROOKFIELD LYNN 10 N24E 80
ASH 22 N57W 27

B. Description of corner evidence found and/or method applied in restoring or reestablishing corner:

JUNE 1996 FOUND 2" IRON PIPE
C. BARGER 3" PINE S32°47'W 10.55'
POWER POLE N6°E 11.88'
12" PINE N50°20'E 32.28'
FOUND 1/2" IRON EAST 49.2'

SURVEY &
REMONUMENTATION


MAY 20 1997

COMMISSION

C. Description of monument for corner and accessories established to perpetuate locating the position of the corner:

I13 1"PIPE 36"LONG WITH 2 1/2" REMONUMENTATION BRASS CAP IN MONUMENT BOX
3" PINE S32°47'W 10.55'
WITNESS TAG IN POWER POLE N6°E 11.88'
WITNESS TAG IN 12" PINE N50°20'E 32.28'
REMONUMENTATION MARKER EAST 49.2'

AND IS ACCEPTED AS A CAREFUL AND FAITHFUL PERPETUATION OF
THE POSITION OF THE ORIGINAL CORNER.

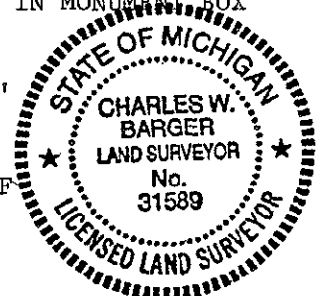

Signed by Charles W. Barger

Date DECEMBER 19, 1996

Surveyor's Michigan License No. 31589

BARGER ENGINEERING, INC.
BERRIEN COUNTY REMONUMENTATION

SOUTHEAST CORNER SECTION 34, TOWNSHIP 6 SOUTH, RANGE 18 WEST
SOUTHWEST CORNER SECTION 35, TOWNSHIP 6 SOUTH, RANGE 18 WEST

113
AALFS ROAD

MARCH 1827 W. BROOKFIELD	SET POST COMMON TO SECTIONS 34 & 35 LYNN 10 N24E 80 ASH 22 N57W 27
JANUARY 1973 D. DREHER	RECORDED SURVEY - LIBER 1, PAGE 256 TIES TO SECTION 35, T6S, R18W TO NW CORNER SECTION 2, T7S, R18W 49.5' EAST
APRIL 1975 R. GARRETT	RECORDED SURVEY - LIBER 997, PAGE 218 TIES TO SECTION 34, T6S, R18W FOUND 1" IRON PIPE CORNER FENCE POST NORTH 27.68' 2" PINE N45E, 32.44' NORTHEAST SECTION 3, T7S, R18W 1/2" IRON EAST 49.5'
JUNE, 1996 C. BARGER	FOUND 2" IRON PIPE 3" PINE S32°47'W 10.55' POWER POLE N6°E 11.88' 12" PINE N50°20'E 32.28' FOUND 1/2" IRON EAST 49.2'

SURVEY &
REMONUMENTATION

MAY 20 1997

COMMISSION