RATHAED BY THE BERMEN COUNTY SURVEY PEER GROUP AS THE			##EGONDE	.U
OFFICIAL CORNER UNDER MICHIGAN 100 JULY 101 JULY		RECORDATION CERTIFICATI	(1) (1) (1) (1) (1) (1) (1) (1) (1) (1)	l ź: 50'
0 31		unty Remonumentation		
9-26-00			BERRIEN COUNTY. N	EEDS ACHIGAN
ro(Lonias in		j	DEKRICK COOKE IN	noman.
Berrien Locate (County)	ed in:	Corner Code #		
Bertrand Twp. T_T_T_	R R R	#002	11/14/00	111#6405 A66 RNER \$9.00 111#6405 A66
	8S R <u>18W</u> 8S R <u>18W</u>	MEANDER CORNER	51	TATE REMON FEE \$2.00
· ·	R	CORNER		
	R		Register of Deeds	Stamp & File Number
4. Lot No, Recorded Plat b. Private Claims			A B C D E F	G H I J K L M
I. DALE L. KESLER , in a hereby state that under requirements of P.A. 7 in lines 1 and 2 above were in conformance current manual of survey instructions of the U Management or by a decree of a Court of Lavand 5 above were in conformance with the reserve of a Court of Law; established, re-est below:	4, Michigan P.A. of 197 with regulations and ru nited States Department and for that the cornerules of the Michigan Box	O, the corner points mentioned les therefore as required in the tof the Interior, Bureau of Land r points mentioned in lines 3, 4 pard of Land Surveyors or by a	2 5 5 4 3 4 7 3 9 9 5 6 18 17 16 7 7 8 1 9 19 MCMSAN ² 1	10 -11 -12 -13 -14 -13 -22 -23 -24
palow;			9 INPANA	
NOTE: Not more than 2 comers, all in the sa	eme town and range, m	sy be recorded	10 30 29 28	27—26—25
on this certificate.			11	
A. Description of original monument and	accessories and/or s	ubsequent restoration:	12 31 32 33	343536
November 17, 1835 Robert Clark, 3 and 23, 33.24 chains to lake set pos 16" H. Oak N 41 ½ W 53 17" R. Oak N 80 E 34	-	th between Section 22	13	
				•
B. Description of corner evidence found	d and/or method appli	ed in restoring or reestablishing	corner:	
Original meander corner was not four 8 South, Range 18 West in the midw Section 23 at the apparent high water	ray point between t	rner on line between the Nor he Southwest corner of Sect	thwest Corner of Sion 22 and the Sour	ection 23, Township theast Corner of
See back of sheet for explanation.				
C. Description of monument for corn	er and accessories es	tablished to perpetuate locating	the position of the co	orner:
Set 3" x 36" concrete monument wire corner.	th brass cap and is	accepted as the best available	e evidence of the p	osition of the original
Nail in 40" Oak N 39 deg 30' E Nail in Fence Post N 07 deg 46' W Nail in Fence Post S 08 deg 46' W Nail in 30" Oak S 40 deg 36' W	84.40' 57.45' 28.76' 46.74'	DALE L. KEGLER * LAND SURVEYOR * NO. 38117		,
0000 (K	O. J.	LAND SURVETER	Date	11/6/00
Signed by	38117	- ABITATION OF THE PERSON OF T	Date	••••
Surveyor's Michigan License No	10011	FURN APPRIVELLEY NEX	MANUSTRIE BURNU UP PROPE	SBRJUML ZUNSVETLIEZ, JAM. 1987, TW/ T
SURVEY &				REVISED MAY 14 1975 REVISED JAN., 1983 REVISED OCT., 1995


REMONUMENTATION

· ·

JAN 3 1 2001

LIBER 4 PAGE 246

SECTION

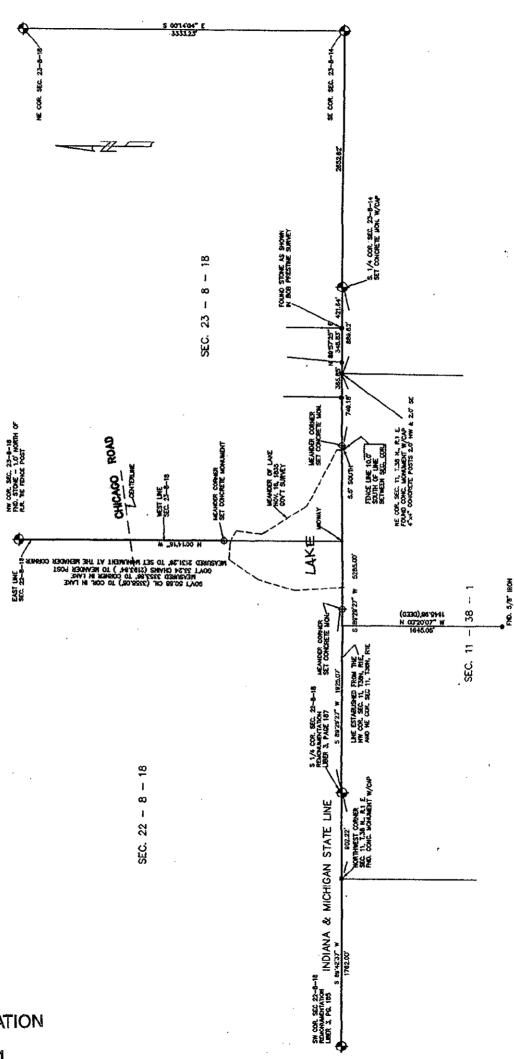

SURVEY & REMONUMENTATION

JAN 31 2001

LIBER 4

PAGE 247

SECTION