

APPROVED

Date 11/25/97 RRC  
CALHOUN COUNTY  
REMONUMENTATION.

For corners in

CALHOUN COUNTY REMONUMENTATION  
LAND CORNER RECORDATION CERTIFICATE  
Filing Requirement of Act 74, Mich. P.A. 1970

STATE OF MICHIGAN  
CALHOUN COUNTY  
RECORDED

1 DEC 97 4:50 P.M.

ANNE B. NORLANDER  
CLERK - REGISTER OF DEEDS

LIBER 1980 PAGE 506

Register of Deeds Stamp & File Number

<u>CALHOUN</u> (County)	Located In:	Corner Code #
BEDFORD TOWNSHIP	T <u>1S</u> R <u>8W</u>	<u>A-8</u>
1. Public Land Survey	T _____ R _____	_____
	T _____ R _____	_____
	T _____ R _____	_____
2. Property Controlling in Section	S _____ T _____ R _____	_____
	S _____ T _____ R _____	_____
3. Miscellaneous Property in Sec.	S _____ T _____ R _____	_____
	S _____ T _____ R _____	_____

4. Lot No. \_\_\_\_\_, Recorded Plat \_\_\_\_\_  
5. Private Claims \_\_\_\_\_

I, ROBERT R. CARR, in a field survey on SEPTEMBER 28, 19 97 do hereby state that under requirements of P.A. 74, Michigan P.A. of 1970, the corner points mentioned in lines 1 and 2 above were in conformance with regulations and rules therefore as required in the current manual of survey instructions of the United States Department of the Interior, Bureau of Land Management or by a decree of a Court of Law and for that the corner points mentioned in lines 3, 4 and 5 above were in conformance with the rules of the Michigan Board of Land Surveyors or by a Decree of a Court of Law; established, re-established, monumented, recovered, found as expressed below:

NOTE: Not more than 2 corners, all in the same town and range, may be recorded on this certificate.

A. Description of original monument and accessories and/or subsequent restoration:

CORNER NOT SET WITH G.L.O. SURVEY 1826 OR RESURVEY 1888.  
1954 AFFIDAVIT BY A.H. CHASE STATES WEST 1/4 POST, SECTION 19 IS LOCATED 2664.0 FEET SOUTH OF NORTHWEST CORNER, SECTION 19 TO CLARIFY DESCRIPTION IN LIBER 675, PAGE 593.  
JANUARY 1993 L.C.R.C. BY JOHN F. KORR, JR. L. 1668, P. 363.  
JUNE 1993 L.C.R.C. BY JOHN F. KORR, JR. REPLACING L. 1668, P. 363 RECORDED L. 1689, P. 843.

1	A	B	C	D	E	F	G	H	I	J	K	L	M
2	6	5	4	3	2	1							
3													
4	7	6	5	4	3	2	1						
5													
6	18	17	16	15	14	13							
7													
8	19	20	21	22	23	24							
9													
10	30	29	28	27	26	25							
11													
12	31	32	33	34	35	36							
13													

SURVEY &  
REMONUMENTATION

APR 07 1998

SECTION

B. Description of corner evidence found and/or method applied in restoring or reestablishing corner:


FOUND 1/2" IRON AND CAP IN MONUMENT BOX PER L.C.R.C., L. 1689, P. 843, AT 2662.96 FEET SOUTH OF NORTHWEST CORNER, SECTION 19, BEDFORD TOWNSHIP.

ACCEPTED THIS LOCATION AS PERPETUATION OF CORNER CALLED FOR BY A.H. CHASE AFFIDAVIT FROM 1954.

REPLACE 1/2" IRON WITH BERNTSEN MONUMENT.

C. Description of monument for corner and accessories established to perpetuate locating the position of the corner:

BERNTSEN MONUMENT IN MONUMENT BOX.  
SET SPOTTER IN 14" MAPLE S55°W, 23.66 FEET  
SET SPOTTER IN 6" ELM N50°W, 27.23 FEET  
SET SPOTTER IN TWIN 5" ELM, S23°E 50.85 FEET  
SET SPOTTER IN 14" POPLAR, S72°E 36.70 FEET  
SET SPOTTER IN 4" MAPLE, N78°E 32.00 FEET  
EAST 1/4 CORNER OF SECTION 24, ROSS TOWNSHIP (KALAMAZOO CO. REMONUMENTATION) NORTH B.54 FEET

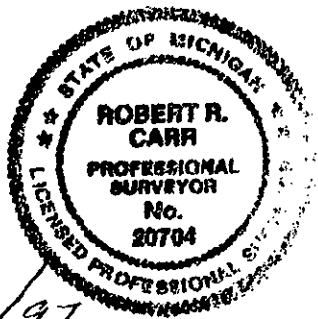

Signed by [Signature]  
Surveyor's Michigan License No. 20704

Date 11/24/97