

150

REMONUMENTATION

FEB 22 1996

COMMISSION

For corners in

CALHOUN (County) BEDFORD TOWNSHIP

CALHOUN COUNTY REMONUMENTATION LAND CORNER RECORDATION CERTIFICATE Filing Requirement of Act 74, Mich. P.A. 1970

APPROVED

Date NOV 20 1995

CALHOUN COUNTY REMONUMENTATION STATE OF MICHIGAN

CALHOUN COUNTY RECORDED

4 DEC 95 2:27 P.M.

ANNE B. NORLANDER CLERK - REGISTER OF DEEDS

Register of Deeds Stamp & File Number

Form with fields for 'Located In', 'Corner Code #', and numbered items 1-5 describing survey details.

Grid table with columns A-M and rows 2-13, containing numbers 1-36.

I, ROBERT R. CARR in a field survey on NOVEMBER 8, 19 95, do hereby certify that under requirements of P.A. 74, Michigan P.A. of 1970, the corner points mentioned in lines 1 and 2 above were in conformance with regulations and rules therefore as required in the current manual of survey instructions of the United States Department of the Interior, Bureau of Land Management or by a decree of a Court of Law and/or that the corner points mentioned in lines 3, 4 and 5 above were in conformance with the rules of the Michigan Board of Land Surveyors or by a Decree of a Court of Law; established, re-established, monumented, re-monumented, recovered, found as expressed below:

NOTE: Not more than 4 corners, all in the same town and range, may be recorded on this certificate.

A. Description of original monument and accessories and/or subsequent restoration:


GLO, SIBLEY, 1826. RE SURVEYED, GIFFORD, 1891, FOUND POST AND ONE U.S. BEARING TREE

B. Description of corner evidence found and/or method applied in restoring or reestablishing corner:

FOUND RE SURVEY TILE, NO WITNESSES REMAINING.

C. Description of monument for corner and accessories established to perpetuate locating the position of the corner:

REPLACED TILE WITH BERNTSEN CALHOUN COUNTY REMON MONUMENT. CARSONITE WITNESS POST, SOUTH, 1.0 FEET. IRON BAR, NORTH, 1.3 FEET. NAIL & SPOTTER IN 14" OAK, N17°W, 35.80 FEET. NAIL & SPOTTER IN 10" OAK, N02°E, 27.14 FEET. NAIL & SPOTTER IN 14" HICKORY, N52°E, 27.45 FEET. NAIL & SPOTTER IN U-POLE, S27°W, 8.80 FEET.

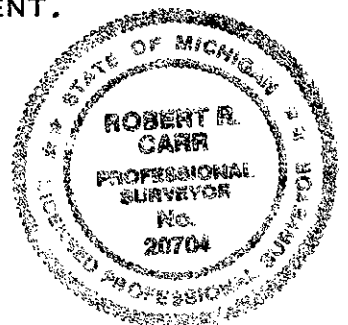

Signed by Robert R. Carr Surveyor's Michigan License No. 20704

Date NOVEMBER 17, 1995

LIBER 1834 PAGE 260