

REMONUMENTATION

FEB 22 1996

COMMISSION

CALHOUN COUNTY REMONUMENTATION
LAND CORNER RECORDATION CERTIFICATE
Filing Requirement of Act 74, Mich. P.A. 1970

APPROVED
Date Oct 18 1995
CALHOUN COUNTY
REMONUMENTATION.

For corners in

Calhoun
(County)

Located In:

Corner Code E-11

1. Public Land Survey

T 1 S R 8 W

E-11

T R

T R

T R

2. Property Controlling
in Section

S T R

S T R

3. Miscellaneous

S T R

Property in Sec.

S T R

STATE OF MICHIGAN
CALHOUN COUNTY
RECORDED

26 OCT 95 10:02 A.M.

Register of Deeds Stamp & File Number
CLERK - REGISTER OF DEEDS

1. Lot No. , Recorded Plat

2. Private Claims

	A	B	C	D	E	F	G	H	I	J	K	L	M
2	6	5	4	3	2	1							
3													
4	7	8	9	10	11	12							
5													
6	18	17	16	15	14	13							
7													
8	19	20	21	22	23	24							
9													
10	30	29	28	27	26	25							
11													
12	31	32	33	34	35	36							
13													

Bedford Township

William K. Crane, in a field survey on October 17, 19 95,
to hereby certify that under requirements of P.A. 74, Michigan P.A. of 1970, the corner points mentioned
in lines 1 and 2 above were in conformance with regulations and rules therefore as required in the
current manual of survey instructions of the United States Department of the Interior, Bureau of Land
Management or by a decree of a Court of Law and/or that the corner points mentioned in lines 3, 4 and 5
above were in conformance with the rules of the Michigan Board of Land Surveyors or by a Decree of a
Court of Law; established, re-established, monumented, re-monumented, recovered, found as
expressed below:

NOTE: Not more than 4 corners, all in the same town and range, may be recorded
on this certificate.

1. Description of original monument and accessories and/or subsequent restoration:

Original Government Field Notes
(S. Sibley 1826):

8" W. Ash N35°W 27 links
12" Lynn N27°E 28 links

Resurvey 1888 by S. Pratt:

Found post set by S. Pratt
in 1877 when U.S. Bearings
were visible. Dug and
found old rotten stake.

5" Sugar S77½°W 43 links
6" Elm N83½°E 151-1/3 links

2. Description of corner evidence found and/or method applied in restoring or reestablishing corner:

This corner is tied into the recorded plat of Kendall Acres No. 3 (L. 15, P. 06). Found
plat monuments and measured to corner location. Found clay tile encased in a 3½" iron
pipe at least 4 feet in length and extending 1' above ground. Believe this was set by
Pratt in 1888 from government bearings and rotten stake as referenced above.


LIBER 1828 PAGE 43

3. Description of monument for corner and accessories established to perpetuate locating the position of the corner:

Removed brass cap from the Standard Calhoun County Remonumentation Monument and drove inside
3½" pipe encasing the clay tile as referenced above.

8" Cherry S20°W 9.44'
8" Elm West 18.15'
12" Oak N10°W 11.50'
8" Elm S20°E 7.90'

This is accepted as a careful and faithful perpetuation of
the position of the original corner.

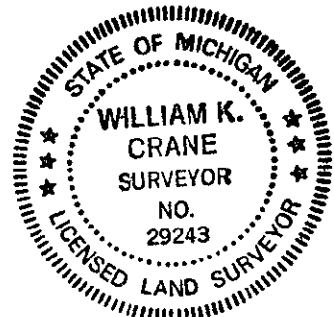

igned by William K. Crane
Surveyor's Michigan License No. 29243

Date October 18, 1995