

SURVEY &  
REMONUMENTATION

1993

COMMISSION

CALHOUN COUNTY REMONUMENTATION  
LAND CORNER RECORDATION CERTIFICATE  
Filing Requirement of Act 74, Mich. P.A. 1970

CLERK-REGISTER  
CALHOUN COUNTY, MICH.  
ANNE B. HOFFLANDER

Oct 26 10 16 AM '93

RECORDED

For corners in

CALHOUN COUNTY (County)	Located In:	Corner Code #
BEDFORD TOWNSHIP		
1. Public Land Survey	T <u>1S</u> R <u>8W</u>	<u>L-11</u>
	T _____ R _____	_____
	T _____ R _____	_____
	T _____ R _____	_____
2. Property Controlling in Section	S _____ T _____ R _____	_____
	S _____ T _____ R _____	_____
3. Miscellaneous Property in Sec.	S _____ T _____ R _____	_____
	S _____ T _____ R _____	_____

Register of Deeds Stamp & File Number

4. Lot No. \_\_\_\_\_, Recorded Plat \_\_\_\_\_  
5. Private Claims \_\_\_\_\_

	A	B	C	D	E	F	G	H	I	J	K	L	M
2	6	5	4	3	2	1							
3													
4	7	8	9	10	11	12							
5													
6	18	17	16	15	14	13							
7													
8	19	20	21	22	23	24							
9													
10	30	29	28	27	26	25							
11													
12	31	32	33	34	35	36							
13													

I, ROBERT R. CARR, in a field survey on SEPTEMBER 9, 19 93, do hereby certify that under requirements of P.A. 74, Michigan P.A. of 1970, the corner points mentioned in lines 1 and 2 above were in conformance with regulations and rules therefore as required in the current manual of survey instructions of the United States Department of the Interior, Bureau of Land Management or by a decree of a Court of Law and/or that the corner points mentioned in lines 3, 4 and 5 above were in conformance with the rules of the Michigan Board of Land Surveyors or by a Decree of a Court of Law; established, re-established, monumented, re-monumented, recovered, found as expressed below:

**NOTE: Not more than 4 corners, all in the same town and range, may be recorded on this certificate.**

A. Description of original monument and accessories and/or subsequent restoration:

L-11 RESURVEY: FOUND POST FROM U.S. BEARING; BR. 0. 10" S43-1/2°W, 94 LKS.; B.O. S46°E, 56 LKS.  
L.W.C. 1937: 8" W.O. S89°E, 42 FT.; 9" B.O. S84°W, 44 FT.; 12" B.O. SOUTH, 49.7 FT.;  
NE CORNER HOUSE S80°W, 97.7 FT.; B.O. NE, 127.4 FT.; 6" BOX ELDER WEST, 78.3 FT.  
PIKE 1974: IRON OVER PIPE; F.H. S35°E, 58.37 FT.; CORNER MONUMENT EAST 32.93 FT.; NE CORNER OF HOUSE S75°W, 97.82 FT. IN LINE WITH FENCE WEST, 2.5 FT EAST OF CENTERLINE OF WASHINGTON AVENUE.  
L.C.R.C. BOOK 1, PAGE 263:


B. Description of corner evidence found and/or method applied in restoring or reestablishing corner:

L-11 FOUND 1/2" RE-BAR OVER CONCRETE MONUMENT.  
FOUND NE CORNER OF HOUSE S73°W, 98.00 FT, PIKE 1974, L.W.C. 1937.  
FOUND FENCE RUNNING WEST, PIKE, 1974.  
FOUND CONCRETE MONUMENT EAST 32.93 FT, PIKE, 1974.

C. Description of monument for corner and accessories established to perpetuate locating the position of the corner:

L-11 REPLACED 1/2" RE-BAR WITH STANDARD CALHOUN COUNTY REMON MONUMENT WITH BRONZE CAP IN MONUMENT BOX.  
NE CORNER HOUSE # 717 FOUNDATION, S73°W, 98.00 FT.  
NAIL & SPOTTER IN TRANSFORMER POLE N31°E, 61.09 FT.  
TOP CENTER OF FIRE HYDRANT S21°E, 58.00 FT.  
FACE OF WESTERLY CORNER POST OF CHAIN LINK FENCE ENCLOSURE N35°E, 52.10 FT.  
FACE OF ANGLE IRON FENCE CORNER POST WEST, 33.27 FT.  
CONCRETE MONUMENT EAST 32.93 FT.

LIBER 1711 PAGE 096

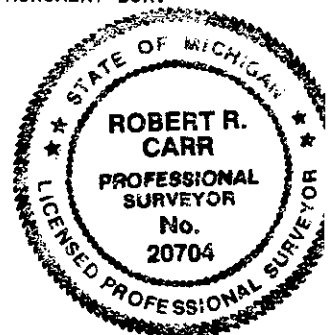

Signed by Robert R. Carr  
Surveyor's Michigan License No. 20704

Date OCT 20, 1993