

MAR 30 1999

APPROVED

Date 10-29-98 MLL
CALHOUN COUNTY
REMONUMENTATION.

CALHOUN COUNTY REMONUMENTATION
LAND CORNER RECORDATION CERTIFICATE
Filing Requirement of Act 74, Mich. P.A. 1970

STATE OF MICHIGAN
CALHOUN COUNTY
RECORDED

29 OCT 1998 2:45:00 PM

For corners in

CALHOUN
(County)
ALBION TWP.

Located In:

Corner Code #

1. Public Land Survey

T3S R4 W

G-6

T R

T R

T R

2. Property Controlling
in Section

S T R

S T R

3. Miscellaneous
Property in Sec.

S T R

S T R

ANNE D. NORLANDER
CLERK - REGISTER OF DEEDS
LIBER 2073 PAGE 297

Register of Deeds Stamp & File Number

4. Lot No. _____, Recorded Plat _____

5. Private Claims _____

I, Frederick J. Cutcher, in a field survey on October 14, 1998 do hereby state that under requirements of P.A. 74, Michigan P.A. of 1970, the corner points mentioned in lines 1 and 2 above were in conformance with regulations and rules therefore as required in the current manual of survey instructions of the United States Department of the Interior, Bureau of Land Management or by a decree of a Court of Law and /or that the corner points mentioned in lines 3, 4 and 5 above were in conformance with the rules of the Michigan Board of Land Surveyors or by a Decree of a Court of Law; established, re-established, monumented, recovered, found as expressed below:

NOTE: Not more than 2 corners, all in the same town and range, may be recorded on this certificate.

A. Description of original monument and accessories and/or subsequent restoration:

G.L.O. by Lucius Lyon, 12/12/1825: Black Oak 13" S 69° E 32 lks; Hickory 5" S 66° W 21 lks.

Witness Card - Lyon, 1826: Black Oak 13" S 69° E 32 lks; Hickory 5" S 66° W 21 lks.

Witness Card - Carr, 11/3/92: Found 1" dia. Concrete post, 4' tall at fence line intersections; 18" Oak S 58° E 30.50'; 16" Hickory N 70° W 13.5'; 6" Oak N 60° E 14.4'; 40" Oak S 35° E 47.4'.

Survey 92-4957 - Carr, 11/3/92: Same information as above, with exception of concrete post being described as 5' tall.

Survey 93-5512 - Carr, 1/26/93: Same information as above.

B. Description of corner evidence found and/or method applied in restoring or reestablishing corner:

On 10/14/98 found "X" in top of 1' diameter x 5' tall concrete post at intersection of fence/tree rows. All of Carr's references of 11/3/92 & 1/26/93 remain.


C. Description of monument for corner and accessories established to perpetuate locating the position of the corner:

Left 1' x 5' concrete post in place and is accepted as a careful and faithful reestablishment of the position of the original corner.

- Found nail & spotter S. side 6" Oak N 45° E 14.4'
- Found nail & spotter S. side 16" Hickory S 80° W 13.5'
- Found nail & spotter N.W. side 18" Oak S 50° E 30.5'
- Top center round wood electric fence post S 22° W 51.15'
- Set nail & spotter W. side 48" Oak S 35° E 47.5'
- Face concrete post N 50° E 16.7'

	A	B	C	D	E	F	G	H	I	J	K	L	M
1													
2		6		5		4		3		2		1	
3													
4		7		8		9		10		11		12	
5													
6		18		17		16	●	15		14		13	
7													
8		19		20		21		22		23		24	
9													
10		30		29		28		27		26		25	
11													
12		31		32		33		34		35		36	
13													

Signed by Frederick J. Cutcher
Surveyor's Michigan License No. 24592

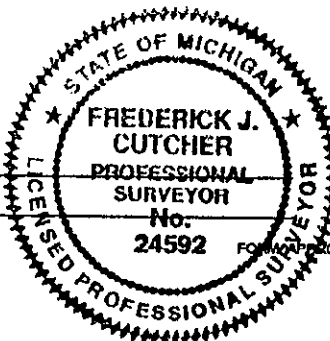

Date 10/19/98