

APPROVED

Date 8-18-99 RCL

CALHOUN COUNTY
REMONUMENTATION.

CALHOUN COUNTY REMONUMENTATION
LAND CORNER RECORDATION CERTIFICATE
Filing Requirement of Act 74, Mich. P.A. 1970

SURVEY &
REMONUMENTATION

SEP 20 1999

SECTION

STATE OF MICHIGAN
CALHOUN COUNTY
RECORDED

8 SEP 1999 9:56:43 AM

ANNE B. NORLANDER
CLERK - REGISTER OF DEEDS

LIBER 2158 PAGE 992

Register of Deeds Stamp & File Number

For corners in

| Calhoun (County) | Located In: | Cornor Code # |
|---------------------------------------|----------------|---------------|
| Eckford Township | | |
| 1. Public Land Survey | T___ R___ | ___ |
| | T___ R___ | ___ |
| | T___ R___ | ___ |
| | T___ R___ | ___ |
| 2. Property Controlling in Section | S 6 T 3S R 5W | 001 |
| | S___ T___ R___ | ___ |
| 3. Miscellaneous Property in Sec. | S___ T___ R___ | ___ |
| | S___ T___ R___ | ___ |

4. Lot No. _____, Recorded Plat _____
5. Private Claims _____

I, William K. Crane, in a field survey on August 5, 1999 do hereby state that under requirements of P.A. 74, Michigan P.A. of 1970, the corner points mentioned in lines 1 and 2 above were in conformance with regulations and rules therefore as required in the current manual of survey instructions of the United States Department of the Interior, Bureau of Land Management or by a decree of a Court of Law and/or that the corner points mentioned in lines 3, 4 and 5 above were in conformance with the rules of the Michigan Board of Land Surveyors or by a Decree of a Court of Law, established, re-established, monumented, recovered, found as expressed below:

NOTE: Not more than 2 corners, all in the same town and range, may be recorded on this certificate.

A. Description of original monument and accessories and/or subsequent restoration:

South 1/4 Corner and Southwest Corner of Section 6, Town 3 South, Range 5 West, falls in Lower Brace Lake and was not set in original government survey. Point set on South Section line at intersection with centerline of 18-1/2 Mile Road, as a reference to the Government Meander Corner. Meander Corner was set 35.00 chains West of the Southeast Corner of Section 6 by Lucius Lyon, 1825:

20" W. Oak N 23° E 22 links

B. Description of corner evidence found and/or method applied in restoring or reestablishing corner:

Found railroad spike at point referenced in legal description of the Supervisor's Plat of Stuart Breeze, according to the Plat thereof recorded in Liber 13 of plats, on page 01. This corner has been used as monumenting the location of the South line of Section 6 in local surveys as well as in the plat referred to above. Excavated at railroad spike to set corner and found 3/4" pipe below railroad spike. This reference monument is located 2112.01 feet East of the Southeast Corner of Section 6.

C. Description of monument for corner and accessories established to perpetuate locating the position of the corner:


Replaced railroad spike and 3/4" pipe with standard Calhoun County Remonumentation Monument (Berntsen Monument) and a monument box, as a reference point for the Government Meander Corner.

| | | |
|----------------------------|---------|----------|
| Southeast Corner Section 6 | East | 2112.01' |
| Twin Maple | N 5° W | 77.0' |
| 8" Pine | N 45° E | 65.19' |
| Utility Pole | South | 67.80' |
| 20" Oak | West | 44.07' |

Signed by William K. Crane
William K. Crane, P.S.

Date September 2, 1999

Surveyor's Michigan License No. 29243

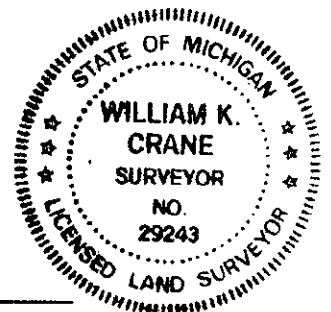

OTC CRANE 2988 27-