

SURVEY &
REMONUMENTATION

1993

CALHOUN COUNTY REMONUMENTATION

COMMISSION

LAND CORNER RECORDATION CERTIFICATE
Filing Requirement of Act 74, Mich. P.A. 1970

For corners in
CALHOUN
(County)

	Located In:	Corner Code #
1. Public Land Survey	T 3 S R 8 W	G-11
	T _____ R _____	_____
	T _____ R _____	_____
	T _____ R _____	_____
2. Property Controlling in Section	S _____ T _____ R _____	_____
	S _____ T _____ R _____	_____
3. Miscellaneous Property in Sec.	S _____ T _____ R _____	_____
	S _____ T _____ R _____	_____

CLERK-REGISTER
 CALHOUN COUNTY, MICH.
 ANNIE B. NORTON ANDERSON
 Oct 26 10 15 AM '93

RECORDED

Register of Deeds Stamp & File Number

- 4. Lot No. _____, Recorded Plat _____
- 5. Private Claims _____

	A	B	C	D	E	F	G	H	I	J	K	L	M
2	6		5		4		3		2		1		
3													
4	7		8		9		10		11		12		
5													
6	18		17		16		15		14		13		
7													
8	19		20		21		22		23		24		
9													
10	30		29		28		27		26		25		
11													
12	31		32		33		34		35		36		
13													

I, DONALD J. DAVIS, in a field survey on OCTOBER 19, 19 93, do hereby certify that under requirements of P.A. 74, Michigan P.A. of 1970, the corner points mentioned in lines 1 and 2 above were in conformance with regulations and rules therefore as required in the current manual of survey instructions of the United States Department of the Interior, Bureau of Land Management or by a decree of a Court of Law and/or that the corner points mentioned in lines 3, 4 and 5 above were in conformance with the rules of the Michigan Board of Land Surveyors or by a Decree of a Court of Law; established, re-established, monumented, re-monumented, recovered, found as expressed below:

NOTE: Not more than 4 corners, all in the same town and range, may be recorded on this certificate.

A. Description of original monument and accessories and/or subsequent restoration:

TILE SET IN 1884 RESURVEY BY HODGMAN AT INTERSECTION OF FENCES.
 10" PEPPERAGE N 74° E 27 LINKS. (GONE)
 6" RED OAK S 20° E 21 LINKS (GONE)


B. Description of corner evidence found and/or method applied in restoring or reestablishing corner:

FOUND TILE IN ROCK PILE AT OLD FENCE CORNER. FENCES DOWN ON GROUND. PIECES OF BRICK AROUND TILE.
 ALL OLD WITNESSES GONE.
 ACCEPTED THIS AS RESTORATION OF ORIGINAL CORNER.

C. Description of monument for corner and accessories established to perpetuate locating the position of the corner:

SET BERTNSEN MONUMENT WITH BRASS CAP OVER BOTTOM SECTION OF TILE, PLACED ROCKS AROUND.
 NAIL & TAG 20" RED OAK NORTH 19.25'.
 NAIL & TAG 18" RED OAK S 85° W 25.38'.
 NAIL & TAG 16" RED OAK S 40° W 14.45'.
 NAIL & TAG 18" MAPLE EAST 27.05'.

LIBER 1711 PAGE 091

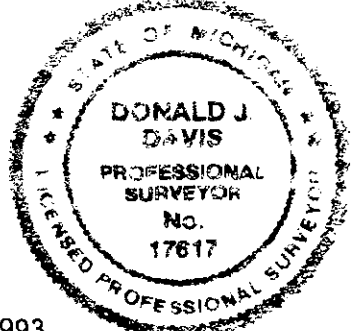

Signed by Donald J. Davis
 Surveyor's Michigan License No. 17617

Date OCTOBER 20, 1993