

APPROVED

Date 12-9-98 KCC  
CALHOUN COUNTY  
REMONUMENTATION.

CALHOUN COUNTY REMONUMENTATION  
LAND CORNER RECORDATION CERTIFICATE  
Filing Requirement of Act 74, Mich. P.A. 1970

STATE OF MICHIGAN  
CALHOUN COUNTY  
RECORDED

15 DEC 1998 3:32:40 PM

For corners in

Calhoun (County)	Located In:	Corner Code #
Leroy Township		
1. Public Land Survey	T 3 S R 8 W	H-9
	T ___ R ___	_____
	T ___ R ___	_____
	T ___ R ___	_____
2. Property Controlling in Section	S ___ T ___ R ___	_____
	S ___ T ___ R ___	_____
3. Miscellaneous Property in Sec.	S ___ T ___ R ___	_____
	S ___ T ___ R ___	_____

ANNE D. NORLANDER  
CLERK - REGISTER OF DEEDS  
LIBER 2087 PAGE 917

Register of Deeds Stamp & File Number

4. Lot No. \_\_\_\_\_ Recorded Plat \_\_\_\_\_  
5. Private Claims \_\_\_\_\_

I, William K. Crane, in a field survey on December 3 19 98 do hereby state that under requirements of P.A. 74, Michigan P.A. of 1970, the corner points mentioned in lines 1 and 2 above were in conformance with regulations and rules therefore as required in the current manual of survey instructions of the United States Department of the Interior, Bureau of Land Management or by a decree of a Court of Law and/or that the corner points mentioned in lines 3, 4 and 5 above were in conformance with the rules of the Michigan Board of Land Surveyors or by a Decree of a Court of Law; established, re-established, monumented, recovered, found as expressed below:

NOTE: Not more than 2 corners, all in the same town and range, may be recorded on this certificate.

A. Description of original monument and accessories and/or subsequent restoration:

GLO Robert Clark, 1826:

18" Y. Oak N 43° W 10½ links  
13" W. Oak S 40° W 13½ links

Resurvey, Hodgman, 1885:

Found "T" iron near surface with crockery, brick and a corner stone under. Set post.  
12" R. Oak S 68° W 131½ links  
16" R. Oak S 25½° E 112 links

A. H. Chase, 1946:

0.8' West of fence North  
10" Catalpa S 45° W 48.6'  
18" Maple N 10° W 26.4'  
10" Hickory N 40° E 44.8'  
30" Elm S 25° E 62.9'  
20" Maple N 85° W 75.3'

B. Description of corner evidence found and/or method applied in restoring or reestablishing corner:

Found pipe over tile and rocks, 2' North of centerline of road.

C. Description of monument for corner and accessories established to perpetuate locating the position of the corner:

Replaced pipe and tile with standard Calhoun County Remonumentation monument (Bermtsen monument with monument box) and is accepted as the best available evidence of the location of the original corner.


Nail and tag in 40" Maple N 03° W 27.08'  
Nail and tag in 22" Red Oak N 80° E 92.73'  
Nail and tag in 12" Twin Maple S 70° E 107.42'  
Nail and tag in 36" Maple S 25° W 82.11'

Signed by William K. Crane

William K. Crane, P.S.

Date December 9, 1998

Surveyor's Michigan License No. 29243

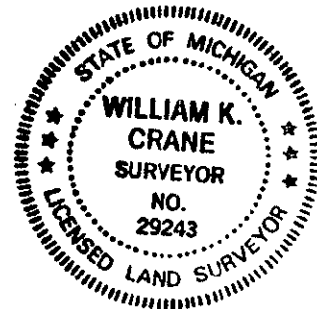

	A	B	C	D	E	F	G	H	I	J	K	L	M
1													
2	6		5		4		3		2		1		
3													
4	7		8		9		10		11		12		
5													
6	18		17		16		15		14		13		
7													
8	19		20		21		22		23		24		
9													
10	30		29		28		27		26		25		
11													
12	31		32		33		34		35		36		
13													