
CALHOUN COUNTY REMONUMENTATION

A	P	P	R	0	V		En	ما
Val	₽	2//	**	َ إِ	Õ	17	カペ	M
RE!	1	O	$\bigcup \mathcal{N}$	C	OU	NT	1	

For come			Filing Requirement of Act 74, Mich. P.A. 1970				REMONUMENTATION.						
Calh	Oun (County)	Located in:	Corner Code #	1									
Burl:	ington Twp.												
1. Public Land Survey T 4 S R 7 W I-9 T R R T R					STATE OF NICHIGAN CALHOUN COUNTY RECORDED								
2. Proper in Se	erty Controlling S	T R T R T R			26	OCT 9	3 10:0	0 A.H.	ı				
3. Misce		T R			er of Dec	WWE B. Id a St a			lum	ber			
4. Lot N	lo Record	ed Plat				ırlin							
	te Claims				A B C	D E	F G	+ +		К.			
					2 6	- <u>\$</u>		i 	<u>2</u> 		-1-		
					3 4 7			10			12-		
L Micha	ael A. Groat _{in a fi}	eld survey on	October 16 , 19 9	95 .	5	_ _	<u> </u>				1		
do hereby	certify that under requireme	nts of P.A. 74, Michigan P.A	A. of 1970, the comer points r	mentioned	6 18	_1 <u>7</u>	-16	15—_		ş	 -13:		
			ules therefore as required in t ent_of_the_Interior,_Bureau		7		+ 1	+	\vdash	+	+		
			mer points mentioned in line		8-19-1	-20	-21	22	23 I	j	-24-		
Decree of	a Court of Law; established	, re-established, monument	ard of Professional Surveyo ted, re-monumented, recover	red, found	9			+	<u>/</u>	_	\top		
•	sed below:				10 30	-29 	-28 	—27—— —	—26 	<u>'</u>	-25-		
	lot more than 4 corners, on this certificate.	all in the same town and	range, may be recorded		12 31	-32	-33-	34	35	j	-36-		
					13				Ш				
A. Desc	1826 Lyon 13" Oak, S 36°W 13" Oak, N 3°E, J. Miller March L.1612, P.887 Set iron at occ 6" Hickory, Nor	, 17 ½ links 57 links 1992 upation	Mad the	uon: L1s 1880 de reference e corner bui y what he us	t does	_							
	8" Elm, N85E, 1												
B. Desc	4" Oak, S40W, 9 cription of corner eviden		, S20E, 21.051 applied in restoring or re	eestablishing co	orner:								
	(L.1612, P.887) around at the o smaller rocks a	Iron was set a ccupation and in round. Held the 1	nd found capped in at occupation and one area found a large rock as a go 5' West of the Mil	no research very large ood perpetua ller Iron.	n was d rock w ation d	lone. with a	Dug seve	g cal					
	France H	ONUMENTATIO)iJ	LIBER	R 1828	PAG	εjγ						
		FEB 2 2 1996	•										
		COMMISSION				c .1.							
C. Desc	cription of monument for	corner and accessories	s established to perpetua	te locating the p	osition o	the c	orner:	-					
	Set Berntsen Moni	ment with carson	ite marker beside	. from which	h:				4.				

Nail and spotter in 6" Hickory, S 40° E, 8.4'
Nail and spotter in Twin 20" Cherry, N 80° E, 1.8'
Nail and spotter in 10" Cherry, S 10° W, 8.6'
Nail and spotter in 6" Hickory, North, 10.2'

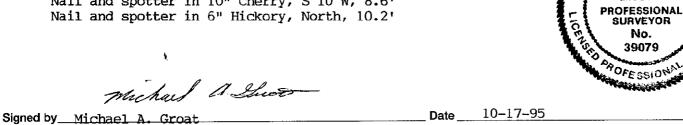

FORM APPROVED BY MICHIGAN STATE BOARD OF PROFESSIONAL SURVEYORS, JAN. 28, 1971 REVISED MAY 14, 1975 REVISED JAN., 1983

GROAT