

SURVEY & REMONUMENTATION

APPROVED

Date 11-28-94
CALHOUN COUNTY
REMONUMENTATION.

CALHOUN COUNTY REMONUMENTATION LAND CORNER RECORDATION CERTIFICATE Filing Requirement of Act 74, Mich. P.A. 1970

APR 26 1995

COMMISSION

STATE OF MICHIGAN
CALHOUN COUNTY
RECORDED

29 NOV 94 10:22 A.M.

ANNE B. NORLANDER
CLERK - REGISTER OF DEEDS

For corners in

CALHOUN (County)	Located In:	Corner Code #
ATHENS TWP.		
1. Public Land Survey	T 4 S R 8 W	F-9
	T R	
	T R	
	T R	
2. Property Controlling in Section	S T R	
	S T R	
3. Miscellaneous	S T R	
Property in Sec.	S T R	

Register of Deeds Stamp & File Number

4. Lot No. _____, Recorded Plat _____
5. Private Claims _____

I, ROBERT R. CARR, in a field survey on NOVEMBER 9, 19 94,
do hereby certify that under requirements of P.A. 74, Michigan P.A. of 1970, the corner points mentioned
in lines 1 and 2 above were in conformance with regulations and rules therefore as required in the
current manual of survey instructions of the United States Department of the Interior, Bureau of Land
Management or by a decree of a Court of Law and/or that the corner points mentioned in lines 3, 4 and 5
above were in conformance with the rules of the Michigan Board of Land Surveyors or by a Decree of a
Court of Law; established, re-established, monumented, re-monumented, recovered, found as
expressed below:

**NOTE: Not more than 4 corners, all in the same town and range, may be recorded
on this certificate.**

A. Description of original monument and accessories and/or subsequent restoration:

ORIGINAL CORNER SET BY DEPUTY SURVEYOR, ROBERT CLARK, 1826.
RE-SURVEY CORNER SET BY COUNTY SURVEYOR, F.A. COURTWRIGHT, 1896.
MEASURED FROM SE CORNER 40.25 CHAINS FOUND STUMP OF BEARING TREE AND SET
POST FROM SAME, ELM 20", S28°W, 12-1/2 LINKS, W. ASH, 12", N34°E, 33-1/2 LINKS.
L.C.R.C., LIBER 1201, PAGE 691 BY BILOW 1980 FOUND 1-1/4 " IRON PIPE SURROUNDED BY
ROCKS AT INTERSECTION OF FENCES, REPLACED WITH 1"X36" IRON PIPE WITH 4" ALUMINUM CAP.


B. Description of corner evidence found and/or method applied in restoring or reestablishing corner:

FOUND 1"X36" IRON PIPE WITH 4" ALUMINUM D.N.R. CAP PER ABOVE L.C.R.C. IN GOOD CONDITION.
DUG AROUND PIPE AND FOUND PIECES OF CROCKERY AND STONES.
ACCEPTED AS PERPETUATED CORNER AND PLACED CARSENITE WITNESS MARKER BESIDE.

LIBER 1778 PAGE 564

C. Description of monument for corner and accessories established to perpetuate locating the position of the corner:

1"X36" IRON PIPE WITH 4" ALUMINUM CAP.
NAIL & SPOTTER IN NE SIDE OF 14" MAPLE N64°W 40.01 FEET.
NAIL & SPOTTER IN SE SIDE OF 18" MAPLE N63°E 38.76 FEET.
NAIL & SPOTTER IN WEST SIDE OF 18" OAK S08°E 63.06 FEET.
NAIL & SPOTTER IN NW SIDE OF 24" MAPLE S26°W 11.51 FEET.
NAIL & SPOTTER IN WESTERLY SIDE OF TWIN 18" MAPLES S29°E 61.12 FEET
ON WEST SIDE OF OLD FENCE CORNER, FENCES NORTH, SOUTH & WEST.

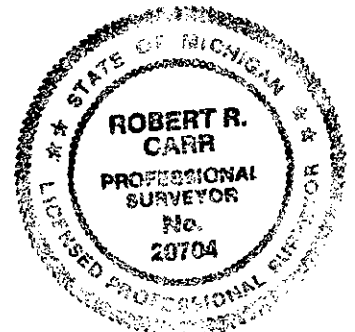

Signed by Robert R. Carr
Surveyor's Michigan License No. 20704

Date NOVEMBER 28, 1994