

LAND CORNER RECORDATION CERTIFICATE  
Filing Requirement of Act 74, Mich. P.A. 1970

For corners in  
Chippewa

(County)

Located In:

Corner Code #

1. Public Land Survey T 42N R 2E A5  
T 42N R 1E M5 (same corner)  
T R  
T R  
2. Property Controlling S T R  
in Section S T R  
3. Miscellaneous S T R  
Property in Sec. S T R


Register of Deeds Stamp & File Number

4. Lot No. , Recorded Plat  
5. Private Claims

Jun 09 2005

I, Stephan J. Szyszkoski, in a field survey on \_\_\_\_\_, 19\_\_\_\_\_, do hereby certify that under requirements of P.A. 74, Michigan P.A. of 1970, the corner points mentioned in lines 1 and 2 above were in conformance with regulations and rules therefore as required in the current manual of survey instructions of the United States Department of the Interior, Bureau of Land Management or by a decree of a Court of Law and/or that the corner points mentioned in lines 3, 4 and 5 above were in conformance with the rules of the Michigan Board of Land Surveyors or by a Decree of a Court of Law; established, re-established, monumented, re-monumented, recovered, found as expressed below:

**NOTE: Not more than 4 corners, all in the same town and range, may be recorded on this certificate.**

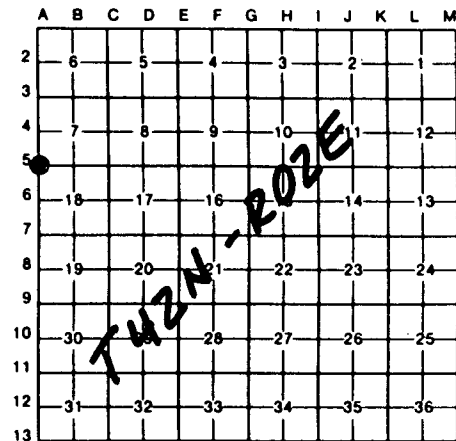

A. Description of original monument and accessories and/or subsequent restoration:


(A5) Corner common to Sections 7 & 18 T42N-R02E and Sections 12 & 13 T42N-R01E. 1840 - Established by Austin Burt, Deputy Surveyor: South on East side of Section 12 ...80.00 Fir 4 corner of Sections 12 and 13. Fir 5 N23W 40 links, Hemlock 10 S27W 35 links. 1947 - Notes of G.F.DeLaMater RLS state: Found Gov't Hemlock BT. [Witnesses:] W Pine S[tump] 36 N18W 50.3, Pointed Stone S15W 59.2. 1/2x24 [believe this is a description of the temp. monument placed at corner position -sjs]. 1973 - record by Billy D. Buckler RLS states "Found original Hemlock witness, a stump, bearing S27W 35 links. part of lower face with overgrowth showing scribe marks in evidence. Piled a mound of stones 2' high at corner, which is located on solid limestone. New Bearings: W.Pine stump N02W 42.4', 7" W.Birch S37W 6.4', W.Birch 7" N14E 35.7'. 1996 - Record of Ronald Bischer RLS, LCRC E 0049 states: Found Conc. Mon. set by DeLaMater. S83E 20.66' 6" Birch, N84W 10.71' 6" Birch, North 42.45' 8" Birch, N13W 50.02' Pine stump.

B. Description of corner evidence found and/or method applied in restoring or reestablishing corner:

(A5) Recovered the 1973 monument of record, as described, at record bearing and distance from the 1973 witnesses. Also recovered a 1/2" dia. rebar encased in a 4" dia. concrete cylinder, likely set by G.F.DeLaMater in 1947. The concrete monument is in accord with both the 1947 and 1996 witnesses. However, the two monuments differ in location. The 1973 stone mound of Mr. Buckler is located N48W 10.0' from the concrete monument of Mr. DeLaMater. As the original Hemlock BT which, according to the records, controlled the location of both of these monuments was not recovered, I cannot account for the difference. The difference in location is relatively small compared to the original record between adjacent corners and hence both locations conform reasonably to that record. By reason of age, character, and use, I accept the 1947 concrete monument as the best available evidence of the position of the original corner.

C. Description of monument for corner and accessories established to perpetuate locating the position of the corner:

(A5) Fd. 1/2" rebar in a 4" dia. conc. cylinder. Set measuring nails in:  
8" W.Birch S80W 15.0' mrd "S13 N8T"  
8" twin W.Birch N05E 42.3' "S7"  
6" Maple in clump N27W 56.3' "S12 N8T"  
7" twin W.Birch S79E 20.55' "S18 N8T"  
Bearings are magnetic. Distances are to nail with tag.

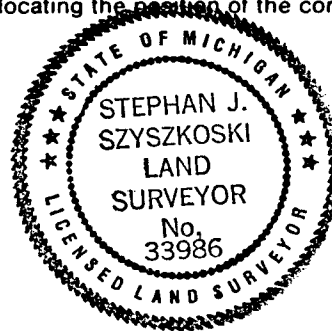

Signed by Stephan J. Szyszkoski  
Surveyor's Michigan License No. 33986  
For the Michigan Department of Natural Resources

Date 1/10/06