

LAND CORNER RECORDATION CERTIFICATE
Filing Requirement of Act 74, Mich. P.A. 1970

For corners in
Chippewa

(County)

Located In:

Corner Code #

1. Public Land Survey T 42N R 2E 87
T R
T R
T R
2. Property Controlling S T R
in Section S T R
3. Miscellaneous S T R
Property in Sec. S T R

Register of Deeds Stamp & File Number

4. Lot No. , Recorded Plat
5. Private Claims

Sep 01 2005

I, Stephan J. Szyszkoski, in a field survey on _____, 19_____, do hereby certify that under requirements of P.A. 74, Michigan P.A. of 1970, the corner points mentioned in lines 1 and 2 above were in conformance with regulations and rules therefore as required in the current manual of survey instructions of the United States Department of the Interior, Bureau of Land Management or by a decree of a Court of Law and/or that the corner points mentioned in lines 3, 4 and 5 above were in conformance with the rules of the Michigan Board of Land Surveyors or by a Decree of a Court of Law; established, re-established, monumented, re-monumented, recovered, found as expressed below:

NOTE: Not more than 4 corners, all in the same town and range, may be recorded on this certificate.

	A	B	C	D	E	F	G	H	I	J	K	L	M
2	6	5	4	3	2	1							
3													
4	7	8	9	10	11	12							
5													
6	18	17	16	15	14	13							
7													
8	19	20	21	22	23	24							
9													
10	30	29	28	27	26	25							
11													
12	31	32	33	34	35	36							
13													

A. Description of original monument and accessories and/or subsequent restoration:


(87) Quarter corner common to Sections 18 and 19. 1845 - Established by John Mullett, Deputy Surveyor: East corrected between Sections 18 and 19 ...41.56 Set Quarter Section post. Fir 10 S10W 11 links, Fir 8 N3E 26 links. ...81.56 Section corner. Found no subsequent record.

B. Description of corner evidence found and/or method applied in restoring or reestablishing corner:

(87) The original post and accessories were not recovered. Found no acceptable evidence of the position of the original corner on the ground. Reestablished the corner by single proportionate measurement to the original record and on the Section line between monumented Section corners 2613.34' east and 2715.25' west.

C. Description of monument for corner and accessories established to perpetuate locating the position of the corner:

(87) Set 1"10x36" I.pipe with 4" alum.
MDNR cap. Set measuring nails in:
6" Balsam N81E 3.45' mrd "1/4S N8T"
7" Spruce N48E 15.82' do
triple 6" Maple N67W 15.28' do
6" Maple S03E 8.57' do
Bearings are magnetic. Distances are to
nail with tag.

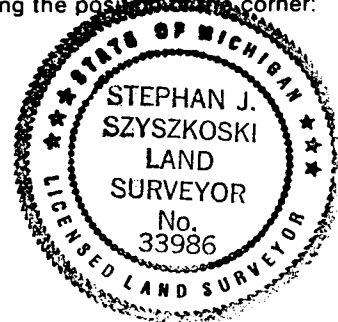

Signed by

Stephan J. Szyszkoski

Date

1/10/06

Surveyor's Michigan License No. 33986
For the Michigan Department of Natural Resources