

60

No. 5 - At Township Corner. T 44 N R 1 E
T 44 N R 2 E
T 45 N R 1 E
T 45 N R 2 E


Found two iron and wood post & cement post.

Telephone pole S 78° W 111.4 feet

" " S 62° E 29.6 "

Pole Culvert W 12' "


Fence Corner post S 44° E 36.0 "

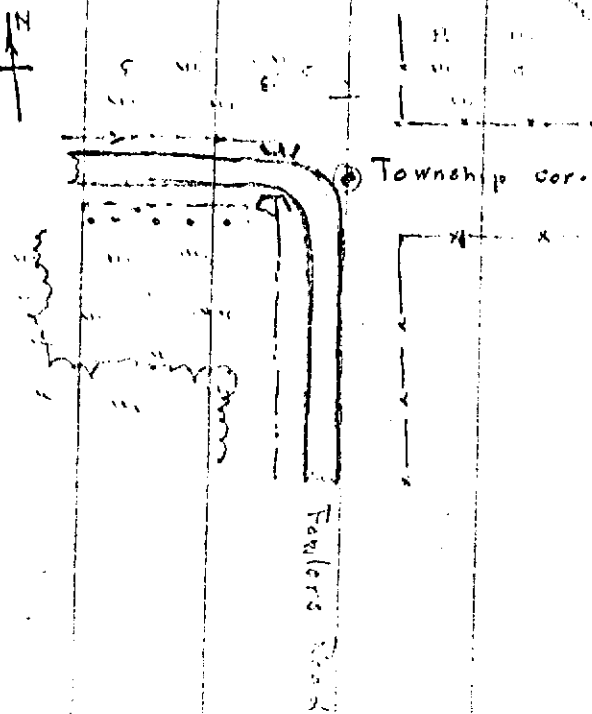

No. 6. North 1/4 Corner of Sec 1. T 44 N R 1 E.

Established 1932.

Sec 36

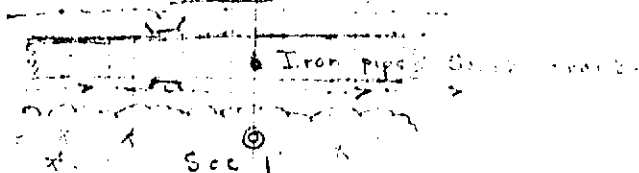

10" Spruce S 22° E 41.3'

6" Spruce S 10° E 35.0'

12" Poplar S 12° W 29.1'

Telephone Pole S 63° E 37.2'


Culvert W 46.2'

3/4 Iron pipe 4' long at corner

Standard Monument 33' South.

No. 7 - Sec Corner

N.W. Cor Sec 1 T 44 N R 1 E.

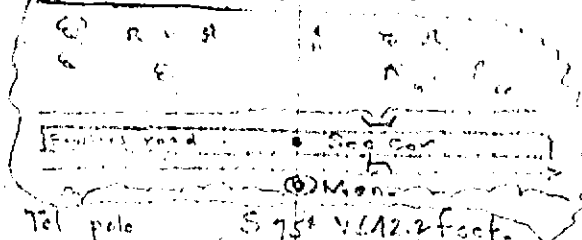

Tel pole S 75° W 112.2 feet.

5" Spruce S 30° W 51.5 "

12" Poplar S 23° W 45.5 "

Culvert E 36.6 "

4" iron pipe at corner. Standard Monument 33' South.