

LAND CORNER RECORDATION CERTIFICATE
Filing Requirement of Act 74, Mich. P.A. 1970

For corners in

Chippewa

(County)

Located In:

Corner Code #

1. Public Land Survey

T 44N R 1E

H8

T R

T R

T R

2. Property Controlling
in Section

S 22

T 44N R 1E

8

S T R

3. Miscellaneous
Property in Sec.

S

T R

S

T R

Register of Deeds Stamp & File Number

4. Lot No. , Recorded Plat

5. Private Claims

Jan 03 2007

I, Stephan J. Szyszkoski, in a field survey on _____, 19____ do hereby state that under requirements of P.A. 74, Michigan P.A. of 1970, the corner points mentioned in lines 1 and 2 above were in conformance with regulations and rules therefore as required in the current manual of survey instructions of the United States Department of the Interior, Bureau of Land Management or by a decree of a Court of Law and /or that the corner points mentioned in lines 3, 4 and 5 above were in conformance with the rules of the Michigan Board of Land Surveyors or by a Decree of a Court of Law; established, re-established, monumented, recovered, found as expressed below:

NOTE: Not more than 2 corners, all in the same town and range, may be recorded on this certificate.

	A	B	C	D	E	F	G	H	I	J	K	L	M
1													
2	6			5		4		3		2		1	
3													
4	7			8		9		10		11		12	
5													
6	18			17		16		15		14		13	
7													
8	19			20		21		22		23		24	
9													
10	30			29		28		27		26		25	
11													
12	31			32		33		34		35		36	
13													

A. Description of original monument and accessories and/or subsequent restoration:

(H8) Center of Section 22. Not established in the original survey.

(8-Sec. 22) West 1/16 corner, Section 22. Not established in the original survey.

B. Description of corner evidence found and/or method applied in restoring or reestablishing corner:

(H8) Established the corner at the intersection of straight lines connecting opposite 1/4 corners.

(8-Sec. 22) Established the corner midway and on a straight line between Quarter corner 1287.52' west and Center of Section 22 1287.52' east. From the position thus established, an E-W fence line is 1' south and a fence line running north is 32.5' east.

C. Description of monument for corner and accessories established to perpetuate locating the position of the corner:

(H8) Set 1"IDx36" I.pipe with plastic cap stamped "MICH DNR PS 33986". Set measuring nails in:

15" Maple N75E 6.83' mrkd "CS BT"

17" Maple N29W 20.75' do

8" Spruce S78W 31.1' do

6" Balsam S03E 24.61' do

Bearings are magnetic. Distances are to nail with tag.

(8) Set 1"IDx36" I.pipe with plastic cap stamped "MICH DNR PS 33986". Set measuring nails in:


wood fence post N29E 89.15'

wood fence post N75W 9.5'

wood fence post S85E 16.85'

4' iron fnc post S83E 42.5' no nail/tag

Bearings are magnetic. Distances are to nail with tag unless noted.

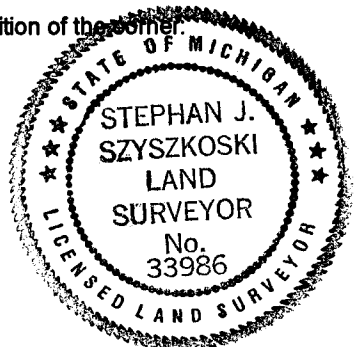

Signed by Stephan J. Szyszkoski

Surveyor's Michigan License No. 33986

Date 1/9/07

For the Michigan Department of Natural Resources