

FEB 23 2001

LAND CORNER RECORDATION CERTIFICATE
Filing Requirement of Act 74, Mich. P.A. 1970
Chippewa County Remonumentation Corner

SECTION

BOOK 11 PAGE 180

For corners in

Chippewa County	Located in:	Corner Code #
1. Public Land Survey	T44N R1W	H-11
	T R	
	T R	
	T R	
2. Property Controlling in Section	S T R	
	S T R	
3. Miscellaneous Property in Sec.	S T R	
	S T R	
4. Lot No.	Recorded Plat	
5. Private Claims		

\$7.00 LAND CORNER

\$2.00 MSSR

Z FEB 2001 3:43:09 PM Receipt #1103

RECEIVED FOR RECORD

CHIPPewa COUNTY - STATE OF MICHIGAN
SHARON H. KENNEDY, REGISTER OF DEEDS

Register of Deeds Stamp & File Number

I, Keith R. Waters, in a field survey on November 8, 2000, do hereby state that under requirements of P.A. 74, Michigan P.A. of 1970, the corner points mentioned in lines 1 and 2 above were in conformance with regulations and rules therefore as required in the current manual of survey instructions of the United States Department of the Interior, Bureau of Land Management or by a decree of a Court of Law and/or that the corner points mentioned in lines 3, 4 and 5 above were in conformance with the rules of the Michigan Board of Land Surveyors or by a Decree of a Court of Law; established, re-established, monumented, recovered, found as expressed below:

NOTE: Not more than 2 corners, all in the same town and range, may be recorded on this certificate.

A. Description of original monument and accessories and/or subsequent restoration:

H-11 1/4 Corner Common to Sections 27 & 34, T44N, R1W.

1845 - Original corner established by James H. Mullett.

Witnesses: Tamarack 10, S39°W 12 links - Tamarack 8, N39°E 17 links.

1896 - Chippewa County Surveyor Frederick H. Brown, RLS 944. Drawing of Section 34 shows the North 1/4 corner midway between section corners 2635 feet east and west. Brown indicates that there were no original corners in Section 34, corners were established by "Kenworthy" for the Township.

1999 - Keith R. Waters, P.S. 33142, LCRC Liber 7, page 345, Chippewa County corner records. Set corner midway on line between section corners east and west. Set 1/2" iron with cap #33142. Witness Power Pole, N62°E 66.34'
Fence Post, S09°W 26.32'
(No other ties available)

B. Description of corner evidence found and/or method applied in restoring or reestablishing corner:

This corner is being perpetuated as part of the Chippewa County Remonumentation Program. Found a 1/2" iron with cap #33142 in the approximate centerline of an east-west gravel road, on line with an old fence to the north and a newer fence to the south. Replaced the found 1/2" iron with a 3/4" rebar and Chippewa County Remonumentation cap and established new witness objects.

C. Description of monument for corner and accessories established to perpetuate locating the position of the corner:

Placed a 3/4" x 24" rebar with a plastic Chippewa County Remonumentation cap at the corner location, replacing a found 1/2" iron with cap #33142. Corner falls in the approximate centerline of an east-west gravel road, on the extension of fence lines north and south.


Witnesses:

Nail and plastic witness tag #33142 in Power Pole (PD3/54/23), N83°W 334.40'

Nail and plastic witness tag #33142 in Power Pole, N56°E 66.30'

Nail and plastic witness tag #33142 in Power Pole, N81°E 449.89'

Nail and plastic witness tag #33142 in Fence Post (cut off power pole), S05°E 27.62'

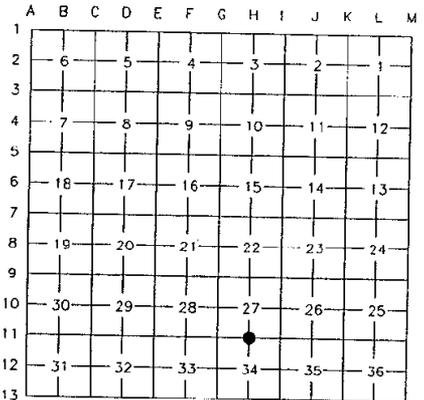

Signed by Keith R. Waters

Date 12-29-00

Surveyor's Michigan License No. 33142