

SURVEY &
REMONUMENTATION

CHIPPEWA COUNTY REMONUMENTATION CORNER

APR 26 1995

LAND CORNER RECORDATION CERTIFICATE
Filing Requirement of Act 74, Mich. P.A. 1970

COMMISSION

For corners in
Chippewa

(County)

Located In:

Corner Code ##

1. Public Land Survey

T 44N R 2W J-1

2. Property Controlling
in Section


S T R

3. Miscellaneous
Property in Sec.

S T R

4. Lot No. , Recorded Plat

5. Private Claims

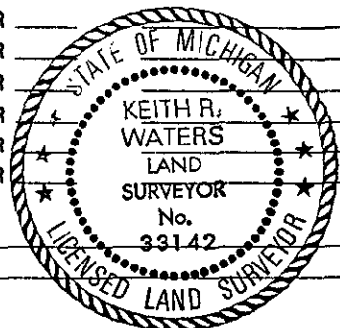

\$ 7.00 LAND CORNER
\$ 2.00 MSSR
19 JAN 95 4:20 P.M. RECEIPT# 2266
RECEIVED FOR RECORD
CHIPPEWA COUNTY - STATE OF MICHIGAN
SHARON H. KENNEDY, REGISTER OF DEEDS
Register of Deeds Stamp & File Number

	A	B	C	D	E	F	G	H	I	J	K	L	M
2	6	5	4	3	2	1							
3													
4	7	8	9	10	11	12							
5													
6	18	17	16	15	14	13							
7													
8	19	20	21	22	23	24							
9													
10	30	29	28	27	26	25							
11													
12	31	32	33	34	35	36							
13													

I, Keith R. Waters, in a field survey on December 12, 19 94,
do hereby certify that under requirements of P.A. 74, Michigan P.A. of 1970, the corner points mentioned
in lines 1 and 2 above were in conformance with regulations and rules therefore as required in the
current manual of survey instructions of the United States Department of the Interior, Bureau of Land
Management or by a decree of a Court of Law and/or that the corner points mentioned in lines 3, 4 and 5
above were in conformance with the rules of the Michigan Board of Land Surveyors or by a Decree of a
Court of Law; established, re-established, monumented, re-monumented, recovered, found as
expressed below:

NOTE: Not more than 4 corners, all in the same town and range, may be recorded
on this certificate.

A. Description of original monument and accessories and/or subsequent restoration:

J-1 North 1/4 Corner of Section 2, T44N, R2W.

Corner was not established in the original survey.

1991 - Corner is shown on a survey drawing by Ronald Bischer, P.S. 22428, as
being mid-way between common section corner 2618.83 feet east and closing
section corner 2618.83 feet west. Witnesses: 18" Spruce, N41°E 9.3',
8" Spruce, N51°W 47.6', 12" Spruce, N85°W 74.0', 1/2" Rod South 1/4 Corner
of Section 35, WEST 16.17'

B. Description of corner evidence found and/or method applied in restoring or reestablishing corner:

J-1 (T44N, R2W)

This corner is being perpetuated as part of the Chippewa County
Remonumentation Program.

Found a 1/2" iron with a plastic cap #22428 on township line mid-way between
common section corner to the east and closing section corner to the west, as
shown on above mentioned survey drawing. Corner is approximately 137 feet
south of the centerline of an east-west gravel road (Aho Road), near a bend to
the south in said road. Accepted corner as found.

C. Description of monument for corner and accessories established to perpetuate locating the position of the corner:

J-1 (T44N, R2W)

Corner is a 1/2" iron with plastic cap #22428, approximately 137 feet south of
the centerline of east-west gravel road (Aho Road). Witnesses:

22" Spruce, N41°E 8.49'
16" Spruce, N17°E 18.98'
12" Spruce, N63°W 47.85'
21" Spruce, N85°W 73.94'
1/2" Iron w/cap #22428 @ South
1/4 Cor. Sec. 35, WEST 16.17'

Note: Distances to trees are to a nail and
tag in the side. Trees are blazed and
painted. Bearings are compass bearings
corrected for declination.



Signed by Keith R. Waters

Date 12-23-94

Surveyor's Michigan License No. 33142