

SURVEY & REMONUMENTATION

APR 26 1995

CHIPPEWA COUNTY REMONUMENTATION CORNER

COMMISSION

LAND CORNER RECORDATION CERTIFICATE
Filing Requirement of Act 74, Mich. P.A. 1970

For corners in
Chippewa

(County)

Located In:

Corner Code #

1. Public Land Survey

T 45N R 1W
T 45N R 2W

A-8 Same
M-8 Corner

2. Property Controlling
In Section


S T R
S T R

3. Miscellaneous
Property in Sec.

S T R
S T R

4. Lot No. , Recorded Plat

5. Private Claims

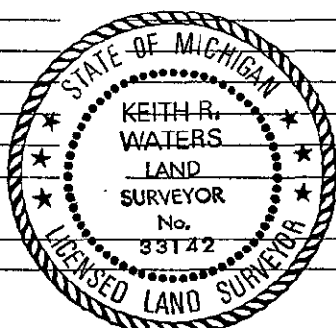

\$ 7.00 LAND CORNER
\$ 2.00 MSSR
19 JAN 95 4:03 P.M. RECEIPT# 2266
RECEIVED FOR RECORD
Register of Deeds Stamp & File Number
CHIPPEWA COUNTY STATE OF MICHIGAN
SHARON H. KENNEDY, REGISTER OF DEEDS

	A	B	C	D	E	F	G	H	I	J	K	L	M
2	6	5	4	3	2	1							
3													
4	7	8	9	10	11	12							
5													
6	18	17	16	15	14	13							
7													
8	19	20	21	22	23	24							
9													
10	30	29	28	27	26	25							
11													
12	31	32	33	34	35	36							

I, Keith R. Waters, in a field survey on December 7, 1994,
do hereby certify that under requirements of P.A. 74, Michigan P.A. of 1970, the corner points mentioned
in lines 1 and 2 above were in conformance with regulations and rules therefore as required in the
current manual of survey instructions of the United States Department of the Interior, Bureau of Land
Management or by a decree of a Court of Law and/or that the corner points mentioned in lines 3, 4 and 5
above were in conformance with the rules of the Michigan Board of Land Surveyors or by a Decree of a
Court of Law; established, re-established, monumented, re-monumented, recovered, found as
expressed below:

**NOTE: Not more than 4 corners, all in the same town and range, may be recorded
on this certificate.**

A. Description of original monument and accessories and/or subsequent restoration:

A-8 1/4 Corner Common to Section 19, T45N, R1W & Section 24, T45N, R2W.

Original ties to post: Tamarack 7, S62°W 18 links Tamarack 8, N79°W 22 links
1991 - As recorded in liber 7, page 335, Chippewa County corner records, by
Keith Waters, P.S. 33142. Set 1/2" iron with cap by single proportionate
measurement between section corners east and west. Witnesses:
10" Red Pine, S50°E 131.80' 4" White Pine, N05°E 73.04'
3" Tamarack, N15°W 21.16' 9" Black Spruce, N05°W 37.34'

B. Description of corner evidence found and/or method applied in restoring or reestablishing corner:

A-8 (T45N, R1W)

This corner is being perpetuated as part of the Chippewa County
Remonumentation Program.

Found a 1/2" iron with plastic cap #33142 and all four bearing trees as called
for in liber 7, page 335. I established this corner in 1991 by single
proportionate measurement on the township line between section corners 2636.05
feet north and 2636.05 feet south. Corner falls in a swampy area south and
east of Highway I-75.


C. Description of monument for corner and accessories established to perpetuate locating the position of the corner:

A-8 (T45N, R1W)

Corner is 1/2" iron with plastic cap #33142. Witnesses:

10" Red Pine, S50°E 131.80'
4" White Pine, N05°E 73.04'
3" Tamarack, N15°W 21.16'
9" Black Spruce, N05°W 37.34'

Note: Distances are to a nail in the side
of the tree. Trees are blazed and painted.
Bearings are compass bearings corrected for
declination.

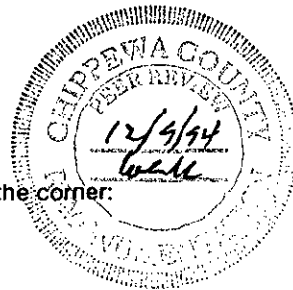

Signed by Keith R. Waters

Date 12-23-94

Surveyor's Michigan License No. 33142