

SURVEY & REMONUMENTATION

APR 26 1995

CHIPPEWA COUNTY REMONUMENTATION CORNER

COMMISSION

LAND CORNER RECORDATION CERTIFICATE


Filing Requirement of Act 74, Mich. P.A. 1970

For corners in

Chippewa (County)	Located In:	Corner Code #
1. Public Land Survey	T <u>45N</u> R <u>1W</u>	<u>C-1</u>
	T _____ R _____	_____
	T _____ R _____	_____
	T _____ R _____	_____
2. Property Controlling in Section	S _____ T _____ R _____	_____
	S _____ T _____ R _____	_____
3. Miscellaneous Property in Sec.	S _____ T _____ R _____	_____
	S _____ T _____ R _____	_____
4. Lot No. _____, Recorded Plat _____		
5. Private Claims _____		

\$ 7.00 LAND CORNER
 \$ 2.00 MSSR
 5 DEC 94 12:26 P.M. RECEIPT# 1518
 RECEIVED FOR RECORD
 CHIPPEWA COUNTY - STATE OF MICHIGAN
 SHARON H. KENNEDY, REGISTER OF DEEDS
Register of Deeds Stamp & File Number

I, William L. Karr, in a field survey on October 28, 19 94, do hereby certify that under requirements of P.A. 74, Michigan P.A. of 1970, the corner points mentioned in lines 1 and 2 above were in conformance with regulations and rules therefore as required in the current manual of survey instructions of the United States Department of the Interior, Bureau of Land Management or by a decree of a Court of Law and/or that the corner points mentioned in lines 3, 4 and 5 above were in conformance with the rules of the Michigan Board of Land Surveyors or by a Decree of a Court of Law; established, re-established, monumented, re-monumented, recovered, found as expressed below:

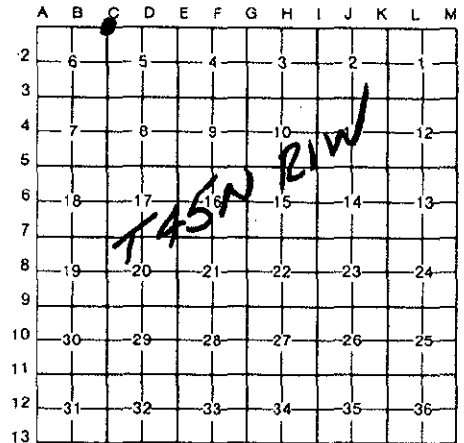


NOTE: Not more than 4 corners, all in the same town and range, may be recorded on this certificate.

A. Description of original monument and accessories and/or subsequent restoration:

(C-1) Closing Corner 6/5, T.45 N., R.1 W

1845: Mullet intersected Township Boundary 18 lks
 East of post. Set post Sections 5 & 6. Birch 12" S47W 06
 Hemlock 12 S31E 20

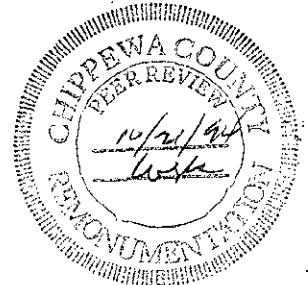

B. Description of corner evidence found and/or method applied in restoring or reestablishing corner:

(C-1) This corner is being re-established as part of the Chippewa County Remonumentation program.

Found no evidence of original corner. Re-established corner 25.08' East of Standard Corner 31/32 (GLO is 25.08') on Township line.

C. Description of monument for corner and accessories established to perpetuate locating the position of the corner:

(C-1) Corner is a 3/4"x 24" iron with aluminum "Chippewa County Remonumentation" cap on approximate centerline of North-South trail.

Witnesses: 10" Maple	N80°W	35.51'
14" W. Birch	S51°W	33.65'
8" Maple	S33°E	23.12'
12" Maple	N82°E	113.40'
Standard Corner 31/32	West	25.08'



Signed by William L. Karr Date 12/2/94

Surveyor's Michigan License No. 27450

723-12

NOTE: Bearings are compass bearings corrected for declination. Distances are to a nail in side of witness objects unless noted.