

**SURVEY &  
REMONUMENTATION**

**CHIPPEWA COUNTY REMONUMENTATION CORNER**


APR 26 1995

**LAND CORNER RECORDATION CERTIFICATE**  
**Filing Requirement of Act 74, Mich. P.A. 1970**

**COMMISSION**  
For corners in  
**Chippewa**

Located In: Corner Code #

- (County)
1. Public Land Survey T 45N R 1W D-7  
T \_\_\_\_\_ R \_\_\_\_\_  
T \_\_\_\_\_ R \_\_\_\_\_  
T \_\_\_\_\_ R \_\_\_\_\_  
T \_\_\_\_\_ R \_\_\_\_\_
2. Property Controlling S \_\_\_\_\_ T \_\_\_\_\_  
in Section S \_\_\_\_\_ T \_\_\_\_\_
3. Miscellaneous S \_\_\_\_\_ T \_\_\_\_\_  
Property in Sec. S \_\_\_\_\_ T \_\_\_\_\_
4. Lot No. \_\_\_\_\_, Recorded Plat \_\_\_\_\_
5. Private Claims \_\_\_\_\_

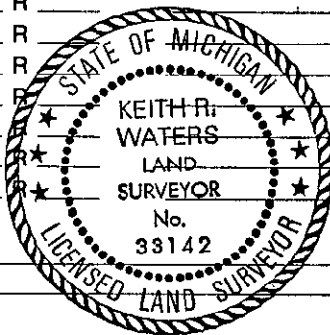

\$ 7.00 LAND CORNER  
\$ 2.00 MSSR  
19 JAN 95 4:12 P.M. RECEIPT# 2266  
RECEIVED FOR RECORD  
CHIPPEWA COUNTY - STATE OF MICHIGAN  
SHARON H. KENNEDY, REGISTER OF DEEDS

Register of Deeds Stamp & File Number

	A	B	C	D	E	F	G	H	I	J	K	L	M
2	6		5		4		3		2		1		
3													
4	7		8		9		10		11		12		
5													
6	18		17		16		15		14		13		
7													
8	19		20		21		22		23		24		
9													
10	30		29		28		27		26		25		
11													
12	31		32		33		34		35		36		
13													

**Keith R. Waters** December 1 94

I, \_\_\_\_\_, in a field survey on \_\_\_\_\_, 19 \_\_\_\_\_, do hereby certify that under requirements of P.A. 74, Michigan P.A. of 1970, the corner points mentioned in lines 1 and 2 above were in conformance with regulations and rules therefore as required in the current manual of survey instructions of the United States Department of the Interior, Bureau of Land Management or by a decree of a Court of Law and/or that the corner points mentioned in lines 3, 4 and 5 above were in conformance with the rules of the Michigan Board of Land Surveyors or by a Decree of a Court of Law; established, re-established, monumented, re-monumented, recovered, found as expressed below:

**NOTE: Not more than 4 corners, all in the same town and range, may be recorded on this certificate.**

A. Description of original monument and accessories and/or subsequent restoration:

D-7 1/4 Corner Common to Sections 17 & 20, T45N, R1W.

Original ties to post: Hemlock 20, N70°E 21 links Spruce 8, S75°W 19 links.  
Corner is shown on survey drawing by Thomas Kelly, RLS 24599.

1991 - As recorded in liber 7, page 336, Chippewa County corner records, by Keith Waters, P.S. 33142. Found 1/2" iron with cap #24599. Witnesses:  
10" Spruce, N10°E 80.46' 10" Aspen, N80°E 13.57'  
10" Aspen, S65°W 15.76' 7" Red Maple, N08°W 38.75'

B. Description of corner evidence found and/or method applied in restoring or reestablishing corner:

D-7 (T45N, R1W)

This corner is being perpetuated as part of the Chippewa County Remonumentation Program.

Found a 1/2" iron with plastic cap #24599 as called for in liber 7, page 336. All bearing trees except for red maple are gone. Corner was established in 1978 by Thomas Kelly, RLS 24599, mid-way on line between section corners east and west. Accepted corner as found and established four new bearing trees.

C. Description of monument for corner and accessories established to perpetuate locating the position of the corner:

D-7 (T45N, R1W)

Corner is a 1/2" iron with plastic cap #24599. Witnesses:

15" White Pine, S29°W 74.30'  
3" Spruce, ine, S55°E 22.94'  
4" Maple Cluster, NORTH 37.86'  
8" Spruce, N47°W 55.79'

Note: Distances are to a nail in the side of the tree. Trees are blazed and painted. Bearings are compass bearings corrected for declination.



Signed by Keith R. Waters

Date 12-23-94

Surveyor's Michigan License No. 33142