

SURVEY & REMONUMENTATION

CHIPPEWA COUNTY REMONUMENTATION CORNER

APR 26 1995


LAND CORNER RECORDATION CERTIFICATE
Filing Requirement of Act 74, Mich. P.A. 1970

For corners in **CHIPPEWA** COMMISSION

(County)

Located In: Corner Code G-11

- 1. Public Land Survey T 45N R 1W G-11
- T _____ R _____
- T _____ R _____
- T _____ R _____
- 2. Property Controlling S _____ T _____
- in Section S _____ T _____
- 3. Miscellaneous S _____ T _____
- Property in Sec. S _____ T _____
- 4. Lot No. _____, Recorded Plat _____
- 5. Private Claims _____

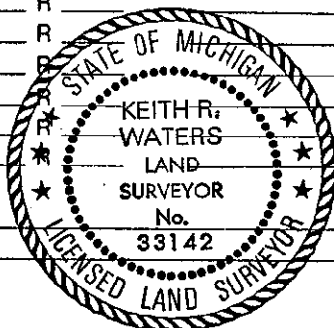

\$ 7.00 LAND CORNER
\$ 2.00 HSSR
19 JAN 95 4:15 P.M. RECEIPT# 2266
RECEIVED FOR RECORD
CHIPPEWA COUNTY - STATE OF MICHIGAN
SHARON H. KENNEDY, REGISTER OF DEEDS

Register of Deeds Stamp & File Number

	A	B	C	D	E	F	G	H	I	J	K	L	M
2	6	5	4	3	2	1							
3													
4	7	8	9	10	11	12							
5													
6	18	17	16	15	14	13							
7													
8	19	20	21	22	23	24							
9													
10	30	29	28	27	26	25							
11													
12	31	32	33	34	35	36							
13													

I, Keith R. Waters in a field survey on August 3, 19 94, do hereby certify that under requirements of P.A. 74, Michigan P.A. of 1970, the corner points mentioned in lines 1 and 2 above were in conformance with regulations and rules therefore as required in the current manual of survey instructions of the United States Department of the Interior, Bureau of Land Management or by a decree of a Court of Law and/or that the corner points mentioned in lines 3, 4 and 5 above were in conformance with the rules of the Michigan Board of Land Surveyors or by a Decree of a Court of Law; established, re-established, monumented, re-monumented, recovered, found as expressed below:


NOTE: Not more than 4 corners, all in the same town and range, may be recorded on this certificate.

A. Description of original monument and accessories and/or subsequent restoration:

G-11 Corner Common to Sections 27, 28, 33, & 34, T45N, R1W.
Original ties to post: Birch 30, S52°W 26 links Birch 18, N58°E 33 links.
1975 - Corner is shown in surveys by Neree Alix, RLS 6254.
1978 - Liber 1, page 302, Billy Buckler, RLS 8887. Found 1" pipe.
1978 - Liber 1, page 353, Thomas Kelly, RLS 24599. Found 1" pipe.
1992 - Liber 8, page 291, Neil Hill, P.S. 27447. Found 1" pipe.

B. Description of corner evidence found and/or method applied in restoring or reestablishing corner:

G-11 (T45N, R1W)
This corner is being perpetuated as part of the Chippewa County Remonumentation Program.
Found a 1" pipe in a monument box in the centerline of Tone Road, at the intersection of asphalt road to the south, as called for in all previous records. Offset pipe with witness hubs prior to re-construction of Tone Road (M-80). Monument box is to be placed in spring, 1995.

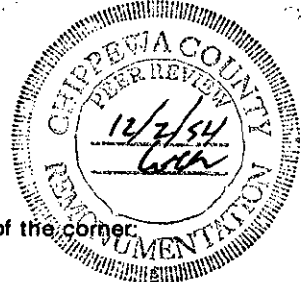

C. Description of monument for corner and accessories established to perpetuate locating the position of the corner:

G-11 (T45N, R1W)
Corner is a 3/4" x 24" rebar with a plastic Chippewa County Remonumentation cap in a monument box to be placed in spring, 1995. Witnesses:
MDOT Tag in Power Pole, S20°W 134.72' Note: Bearings are based on MDOT records.
MDOT Tag in Power Pole, N40°W 42.88'
MDOT Tag in 9" Maple, N20°E 86.83'
MDOT Tag in 30" Oak, S12°E 198.52'

Signed by Keith R. Waters Date 12-23-94
Surveyor's Michigan License No. 33142