

# SURVEY & REMONUMENTATION

APR 26 1995

## CHIPPEWA COUNTY REMONUMENTATION CORNER

### COMMISSION

### LAND CORNER RECORDATION CERTIFICATE

Filing Requirement of Act 74, Mich. P.A. 1970

For corners in  
Chippewa

Located In:

Corner Code #

1. Public Land Survey

T 45N R 1W H-11

2. Property Controlling  
in Section


S T

3. Miscellaneous  
Property in Sec.

S T

4. Lot No. , Recorded Plat

5. Private Claims

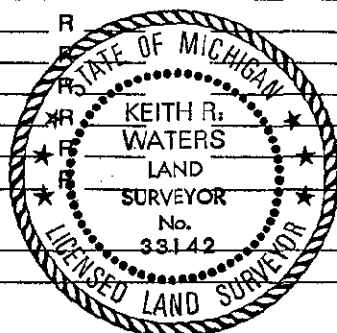

\$ 7.00 LAND CORNER

\$ 2.00 MSSR

19 JAN 95 4:16 P.M. RECEIPT# 2266

RECEIVED FOR RECORD

CHIPPEWA COUNTY - STATE OF MICHIGAN  
SHARON H. KENNEDY, REGISTER OF DEEDS

Register of Deeds Stamp & File Number

Keith R. Waters

August 4

94

I, in a field survey on 19 do hereby certify that under requirements of P.A. 74, Michigan P.A. of 1970, the corner points mentioned in lines 1 and 2 above were in conformance with regulations and rules therefore as required in the current manual of survey instructions of the United States Department of the Interior, Bureau of Land Management or by a decree of a Court of Law and/or that the corner points mentioned in lines 3, 4 and 5 above were in conformance with the rules of the Michigan Board of Land Surveyors or by a Decree of a Court of Law; established, re-established, monumented, re-monumented, recovered, found as expressed below:

**NOTE:** Not more than 4 corners, all in the same town and range, may be recorded on this certificate.

A. Description of original monument and accessories and/or subsequent restoration:

H-11 1/4 Corner Common to Sections 27 & 34, T45N, R1W.

Original ties to post: Maple 10, S01°W 18 links Sugar 20, N03°E 30 links.  
1978 - As recorded in liber 1, page 302, Chippewa County corner records, by Billy Buckler, RLS 8887. Found 1" pipe in center of Tone Road.  
1992 - As recorded in liber 8, page 293, Chippewa County corner records, by Neil E. Hill, P.S. 27447. Set monument box over found 1" pipe.

B. Description of corner evidence found and/or method applied in restoring or reestablishing corner:

H-11 (T45N, R1W)

This corner is being perpetuated as part of the Chippewa County Remonumentation Program.

Found a 1" pipe in a monument box in the centerline of Tone Road, west of road to the south, as recorded in liber 8, page 223. Corner is 2666.22 feet from section corner to the west, 2654.31 feet from section corner to the east, and is 16.06 feet south of a straight line between said section corners. This fits very well with a breakdown of Section 27, done by the Department of Natural Resources in 1978. Witnessed 1" pipe with witness hubs prior to re-construction of Tone Road. Monument box is to be placed in spring, 1995.


C. Description of monument for corner and accessories established to perpetuate locating the position of the corner:

H-11 (T45N, R1W)

Corner is a 3/4" x 24" rebar with a plastic Chippewa County Remonumentation cap in a monument box to be placed in spring, 1995. Witnesses:

MDOT Tag in 7" Spruce, N25°W 84.92'  
MDOT Tag in Power Pole, N55°E 90.99'  
MDOT Tag in Twin 4" Poplar, S45°E 78.01'  
Chiseled "+" on Large Stone, SOUTH 49.08'

Note: Bearings are based on MDOT records.

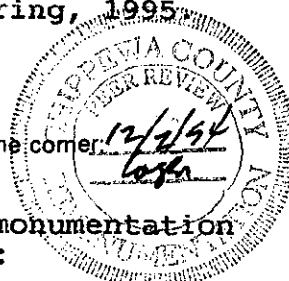

Signed by Keith R. Waters

Date 12-23-94

Surveyor's Michigan License No. 33142