

SURVEY & REMONUMENTATION

CHIPPEWA COUNTY REMONUMENTATION CORNER

APR 26 1995

LAND CORNER RECORDATION CERTIFICATE
Filing Requirement of Act 74, Mich. P.A. 1970

For corners in **CHIPPEWA** **COMMISSION**

Located In: _____ Corner Code # _____

1. Public Land Survey T 45N R 1W K-9

T _____ R _____

T _____ R _____

T _____ R _____

2. Property Controlling S _____ T _____ R _____


in Section S _____ T _____ R _____

3. Miscellaneous S _____ T _____ R _____

Property in Sec. S _____ T _____ R _____

4. Lot No. _____, Recorded Plat _____

5. Private Claims _____

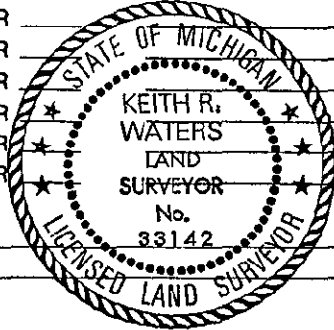

\$ 7.00 LAND CORNER
 \$ 2.00 MSSR
 19 JAN 95 4:17 P.M. RECEIPT# 2266
 RECEIVED FOR RECORD
 CHIPPEWA COUNTY - STATE OF MICHIGAN
 SHARON H. KENNEDY, REGISTER OF DEEDS

Register of Deeds Stamp & File Number

	A	B	C	D	E	F	G	H	I	J	K	L	M
2	6		5		4		3		2		1		
3													
4	7		8		9		10		11		12		
5													
6	18		17		16		15		14		13		
7													
8	19		20		21		22		23		24		
9													
10	30		29		28		27		26		25		
11													
12	31		32		33		34		35		36		
13													

I, Keith R. Waters in a field survey on December 12, 1994, do hereby certify that under requirements of P.A. 74, Michigan P.A. of 1970, the corner points mentioned in lines 1 and 2 above were in conformance with regulations and rules therefore as required in the current manual of survey instructions of the United States Department of the Interior, Bureau of Land Management or by a decree of a Court of Law and/or that the corner points mentioned in lines 3, 4 and 5 above were in conformance with the rules of the Michigan Board of Land Surveyors or by a Decree of a Court of Law; established, re-established, monumented, re-monumented, recovered, found as expressed below:

NOTE: Not more than 4 corners, all in the same town and range, may be recorded on this certificate.

A. Description of original monument and accessories and/or subsequent restoration:

K-9 Corner Common to Sections 23, 24, 25, & 26, T45N, R1W.

Original ties to post: Spruce 12, S42°W 23 links Cedar 4, N66°W 19 links.
 1986 - Corner was set by Earl Strater, P.S. 28424, for a survey in Section 24. Corner was established on the westerly extension of the line between 1/4 corner L-9 and section corner M-9, at equal distance between said corners (2471.32 feet), which is consistent with County Surveyor notes from the early 1900's.

B. Description of corner evidence found and/or method applied in restoring or reestablishing corner:

K-9 (T45N, R1W)
 This corner is being perpetuated as part of the Chippewa County Remonumentation Program.
 Found a 1/2" iron with a plastic cap #28424. Distances to 1/4 corner and section corner to the east fit well with County Surveyor notes, as mentioned above, but vary considerably from GLO distances. The north-south dimensions of the sections in this area are very inconsistent with both GLO and County Surveyor notes. Accepted corner as found.



C. Description of monument for corner and accessories established to perpetuate locating the position of the corner:

K-9 (T45N, R1W)
 Corner is a 1/2" iron with plastic cap #28424 approximately 10 feet uphill from the base of a steep hill. Witnesses:

- 7" Cherry, N57°W 10.01'
- 12" Cedar, S51°E 26.87'
- 8" Cedar, S66°E 24.19'
- 11" Spruce, S83°E 30.98'

Note: Distances are to nail and tag in side of the tree. Trees are blazed and painted. Bearings are compass bearings corrected for declination.

Signed by Keith R. Waters Date 12-23-94

Surveyor's Michigan License No. 33142