

SURVEY & REMONUMENTATION

CHIPPEWA COUNTY REMONUMENTATION CORNER

APR 26 1995

LAND CORNER RECORDATION CERTIFICATE
 Filing Requirement of Act 74, Mich. P.A. 1970

For corners **COMMISSION**
 Chippewa

Located In: _____ Corner Code ## _____

(County) _____


1. Public Land Survey T 45N R 1W K-11
 T _____ R _____
 T _____ R _____
 T _____ R _____

2. Property Controlling S _____ T _____
 in Section S _____ T _____

3. Miscellaneous S _____ T _____
 Property in Sec. S _____ T _____

4. Lot No. _____, Recorded Plat _____

5. Private Claims _____

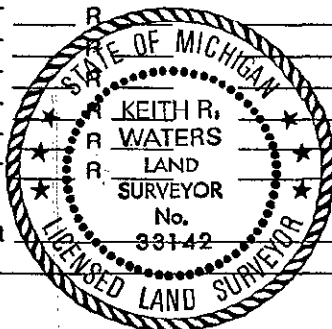

\$ 7.00 LAND CORNER
 \$ 2.00 HSSR
 19 JAN 95 4:18 P.M. RECEIPT# 2266
 RECEIVED FOR RECORD
 CHIPPEWA COUNTY - STATE OF MICHIGAN
 SHARON H. KENNEDY, REGISTER OF DEEDS
Register of Deeds Stamp & File Number

	A	B	C	D	E	F	G	H	I	J	K	L	M
2	6		5		4		3		2		1		
3													
4	7		8		9		10		11		12		
5													
6	18		17		16		15		14		13		
7													
8	19		20		21		22		23		24		
9													
10	30		29		28		27		26		25		
11													
12	31		32		33		34		35		36		
13													

I, Keith R. Waters, in a field survey on August 4, 1994, do hereby certify that under requirements of P.A. 74, Michigan P.A. of 1970, the corner points mentioned in lines 1 and 2 above were in conformance with regulations and rules therefore as required in the current manual of survey instructions of the United States Department of the Interior, Bureau of Land Management or by a decree of a Court of Law and/or that the corner points mentioned in lines 3, 4 and 5 above were in conformance with the rules of the Michigan Board of Land Surveyors or by a Decree of a Court of Law; established, re-established, monumented, re-monumented, recovered, found as expressed below:

NOTE: Not more than 4 corners, all in the same town and range, may be recorded on this certificate.

A. Description of original monument and accessories and/or subsequent restoration:

K-11 Corner Common to Sections 25, 26, 35, & 36, T45N, R1W.

Original ties to post: Hemlock 24, S56°W 47 links Birch, 12, N60°E 21 links. 1965 - Highway Department, as recorded in liber 2, page 226, Chippewa County corner records. Replaced original corner from pre-construction witnesses with a 1" iron pin.

1992 - As recorded in liber 8, page 295, Chippewa County corner records, by Neil E. Hill, P.S. 27447. Found 1" iron pin in a monument box and all three witness tags from 1965 records.

B. Description of corner evidence found and/or method applied in restoring or reestablishing corner:

K-11 (T45N, R1W)
 This corner is being perpetuated as part of the Chippewa County Remonumentation Program.
 Found a 1" iron bar in a monument box in the approximate centerline of Tone Road (M-80). Offset iron with witness hubs prior to re-construction of Tone Road. Monument box to be placed in spring, 1995.



C. Description of monument for corner and accessories established to perpetuate locating the position of the corner:

K-11 (T45N, R1W)
 Corner is a 3/4" x 24" rebar with a plastic Chippewa County Remonumentation cap in a monument box to be placed in spring, 1995. Witnesses:

Highway Tag in 16" White Birch, S45°W 68.56' Note: Bearings are based on
 Highway Tag in Power Pole, N38°W 68.22' MDOT records.
 Highway Tag in 14" Spruce, N25°E 58.47'
 MDOT Tag in 8" Poplar, S10°W 60.38'

Signed by Keith R. Waters Date 12-23-94
 Surveyor's Michigan License No. 33142