

**SURVEY &
REMONUMENTATION**

APR 26 1995

CHIPPEWA COUNTY REMONUMENTATION CORNER

COMMISSION

LAND CORNER RECORDATION CERTIFICATE

Filing Requirement of Act 74, Mich. P.A. 1970

For corners in
Chippewa

(County)

Located In:

Corner Code **##**

1. Public Land Survey

T 45N R 2W F-13

T _____ R _____

T _____ R _____

T _____ R _____

2. Property Controlling
in Section

S _____ T _____ R _____

3. Miscellaneous


S _____ T _____ R _____

Property in Sec.

S _____ T _____ R _____

4. Lot No. _____, Recorded Plat _____

5. Private Claims _____

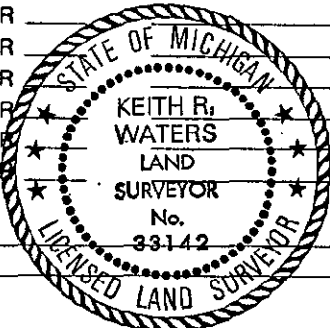

\$ 7.00 LAND CORNER

\$ 2.00 MSSR

19 JAN 95 4:21 P.M. RECEIPT# 2266

RECEIVED FOR RECORD

CHIPPEWA COUNTY - STATE OF MICHIGAN

SHARON H. KENNEDY, REGISTER OF DEEDS

Register of Deeds Stamp & File Number

Keith R. Waters

November 18

94

I, Keith R. Waters, in a field survey on November 18, 1994, do hereby certify that under requirements of P.A. 74, Michigan P.A. of 1970, the corner points mentioned in lines 1 and 2 above were in conformance with regulations and rules therefore as required in the current manual of survey instructions of the United States Department of the Interior, Bureau of Land Management or by a decree of a Court of Law and/or that the corner points mentioned in lines 3, 4 and 5 above were in conformance with the rules of the Michigan Board of Land Surveyors or by a Decree of a Court of Law; established, re-established, monumented, re-monumented, recovered, found as expressed below:

NOTE: Not more than 4 corners, all in the same town and range, may be recorded on this certificate.

A. Description of original monument and accessories and/or subsequent restoration:

F-13 South 1/4 Corner of Section 33, T45N, R2W.

Original notes indicate a 5 inch diameter fir for corner.

1959 - Highway Department, as recorded in liber 3, page 225, page 225. Found 1 1/2" iron pin. Witnesses: Fence Post, N50°W 35.29' T Pole, S50°W 33.24'. Corner is called out as being the north 1/4 corner of Section 4, T44N, R2W, it does not appear that double corners were recognized.

B. Description of corner evidence found and/or method applied in restoring or reestablishing corner:

F-13 (T45N, R2W)

This corner is being re-established as part of the Chippewa County Remonumentation Program.

Found a 1 1/2" iron pipe in the centerline of an east-west gravel road (18 Mile Road), as called for in liber 3, page 225, which appears to be at the north 1/4 corner of Section 4, T44N, R2W. Re-established corner mid-way between standard section corners 2635.69 feet east and 2635.69 feet west, on the extension of the line between standard section corner to the east and the north 1/4 corner of Section 4, T44N, R2W. Corner falls 15.01 feet west of said north 1/4 corner of Section 4.

C. Description of monument for corner and accessories established to perpetuate locating the position of the corner:

F-13 (T45N, R2W)

Corner is a 3/4" rebar with a plastic Chippewa County Remonumentation cap in the centerline of an east-west gravel road (18 Mile Road). Witnesses:

14" Apple, N61°E 83.87'
6" Spruce, N06°E 82.43'
Power Pole, S70°E 136.69'
Power Pole (P23-100), N76°W 118.40'
1 1/2" Pipe @ N 1/4 Corner Sec. 4,
EAST 15.01'

Note: Distances to poles and trees are to a nail with either a tag or cap #29251. Bearings are compass bearings corrected for declination.

Signed by Keith R. Waters

Date 12-23-94

Surveyor's Michigan License No. 33142