

SECTION

LAND CORNER RECORDATION CERTIFICATE
Filing Requirement of Act 74, Mich. P.A. 1970
Chippewa County Remonumentation Corner

For corners in

Table with columns: Chippewa County, Located in:, Corner Code #. Rows include Public Land Survey, Property Controlling in Section, Miscellaneous Property in Sec., Lot No., and Private Claims.

BOOK 11 PAGE 103

\$7.00 LAND CORNER
\$2.00 MSSR
23 FEB 2000 4:25:56 PM Receipt #21179
RECEIVED FOR RECORD
CHIPPWEA COUNTY - STATE OF MICHIGAN
SHARON H. KENNEDY, REGISTER OF DEEDS
Register of Deeds Stamp & File Number

I, Keith R. Waters, in a field survey on January 25, 1999, do hereby state that under requirements of P.A. 74, Michigan P.A. of 1970, the corner points mentioned in lines 1 and 2 above were in conformance with regulations and rules therefore as required in the current manual of survey instructions of the United States Department of the Interior, Bureau of Land Management or by a decree of a Court of Law and /or that the corner points mentioned in lines 3, 4 and 5 above were in conformance with the rules of the Michigan Board of Land Surveyors or by a Decree of a Court of Law; established, re-established, monumented, recovered, found as expressed below:

NOTE: Not more than 2 corners, all in the same town and range, may be recorded on this certificate.

A. Description of original monument and accessories and/or subsequent restoration:

G-12 1/4 Corner Common to Sections 33 & 34, T46N, R7W

1850 - Original corner established by Wells Burt, a spruce post.
Witnesses: Tamarack 6, N58°W 05 links - Tamarack 6, S65 1/2°E 48 links.

1963 - Billy D. Buckler, R.L.S. 8887, Michigan Department of Conservation, Forestry Division, Land Corner Record, as recorded in Liber 3, Page 96, Chippewa County Corner Records. Corner replaced from two original tamarack bearing trees. Corner found by Marcus Burnis, Forestry Aide, while running lines in this area. Set a 1" pipe with a 4" aluminum cap. New witnesses:
7" Black Spruce (1/4 S NBT), S85°E 34 links
7" Black Spruce (1/4 S NBT), S05°W 14 links



B. Description of corner evidence found and/or method applied in restoring or reestablishing corner:

This corner is being perpetuated as part of the Chippewa County Remonumentation Program. Found a 1" pipe with a stamped aluminum Department of Conservation cap next to a cedar post. Also found one of the record bearing trees (spruce S85°E 34 links) as called for in the above mentioned 1963 records. Tree is dead, but still standing. Accepted corner as found and established new bearing trees.

C. Description of monument for corner and accessories established to perpetuate locating the position of the corner:

Found a 1" pipe with a stamped aluminum Department of Conservation cap at the corner location, next to an old cedar post and a new tamarack post.
Witnesses:
Blazed 4" Spruce, N67°E 21.85'
Blazed 4" Tamarack, S32°E 14.17'
Blazed 4" Tamarack, S44°W 36.81'
Blazed 4" Spruce, N54°W 31.65'

Grid table with columns A-M and rows 1-13. A dot is marked at the intersection of column E and row 12.

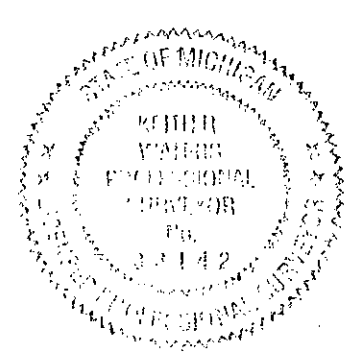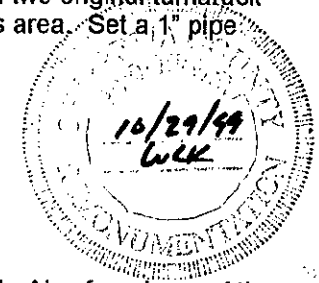

Signed by Keith R. Waters

Date 12-29-99

Surveyor's Michigan License No. 33142