

CHIPPEWA COUNTY REMONUMENTATION CORNER

SURVEY
REMONUMENTATION

N

LAND CORNER RECORDATION CERTIFICATE

Filing Requirement of Act 74, Mich. P.A. 1970

JUL 22 1999

For corners in

Chippewa

(County)

Located In:

Corner Code #

SECTION

1. Public Land Survey

T 46N R 1E

K-3/L-3 #2

T R

T R

T R

T R

2. Property Controlling
In Section

S T R

S T R

3. Miscellaneous

S T R

Property In Sec:

S T R

\$ 7.00 LAND CORNER

\$ 2.00 MSSR

5 DEC 94 12:08 P.M. RECEIPT# 1517

RECEIVED FOR RECORD

CHIPPEWA COUNTY - STATE OF MICHIGAN

SHARON H. KENNEDY, REGISTER OF DEEDS

Register of Deeds Stamp & File Number

4. Lot No. , Recorded Plat

5. Private Claims

William L. Karr

November 09

19 94

I hereby certify that under requirements of P.A. 74, Michigan P.A. of 1970, the corner points mentioned in lines 1 and 2 above were in conformance with regulations and rules therefore as required in the current manual of survey instructions of the United States Department of the Interior, Bureau of Land Management or by a decree of a Court of Law and/or that the corner points mentioned in lines 3, 4 and 5 above were in conformance with the rules of the Michigan Board of Land Surveyors or by a Decree of a Court of Law; established, re-established, monumented, re-monumented, recovered, found as expressed below:

NOTE: Not more than 4 corners, all in the same town and range, may be recorded on this certificate.

a. Description of original monument and accessories and/or subsequent restoration:


(K-3/L-3) Meander Corner Sections 1 & 12, T.46 N., R.1 E.

1845: J. Mullett set meander post 9.5 chains (627') East of Section corner

at river. Birch 24 S86W 2.55

Birch 16 N79W 2.67

	A	B	C	D	E	F	G	H	I	J	K	L	M
2	6	5	4	3	2	1							
3													
4	7	8	9	10	11	12							
5													
6	18	17	16	15	14	13							
7													
8	19	20	21	22	23	24							
9													
10	30	29	28	27	26	25							
11													
12	31	32	33	34	35	36							
13													

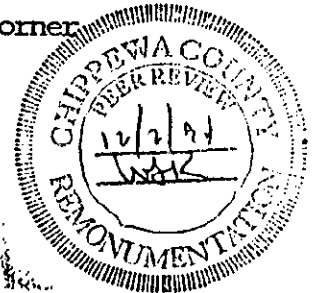

Description of corner evidence found and/or method applied in restoring or reestablishing corner:

(K-3/L-3) This corner is being re-established as part of the Chippewa County Remonumentation program.

Found no evidence of original corner which now falls in the St. Mary's River. Using the "Plat of Loma Beach" and "Padgett's Nicolet Lake Subdivision", the line between Sections 1 and 12 was reconstructed and a position for a "Witness Corner to the Meander Corner" (WCMC) was established 617.92 feet East of the Section corner. This position (and the entire line) fall in a deep drainage ditch. The WCMC was set 33.00' North of this point (perpendicular to the Section line)

Description of monument for corner and accessories established to perpetuate locating the position of the corner:

(K-3/L-3) Corner is a 3/4"x 48" iron w/stamped aluminum cap set 33.00' North of and perpendicular to the Section line, 617.92' East of the Section corner.

Witnesses: 15" Spruce

N35°W 135.52'

15" W. Pine

N48°W 171.35'

10" Maple

N90°W 123.59'

USCE Monument (C4W-109)

S33°W 83.40'

Note: Trees are not blazed.



Surveyed by William L. Karr

Date 12/2/94

Surveyor's Michigan License No. 27450

723-12

NOTE: Bearings are compass bearings corrected for declination.

Distances are to a nail in side of witness objects unless noted.

FORM APPROVED BY MICHIGAN STATE BOARD OF LAND SURVEYORS, JAN. 28, 1971

REVISED MAY 14, 1975

REVISED JAN. 2000

L. 8 pg 399 Other Code: 2