

Chippewa County Remonumentation Corner

JUL 22 1999

LAND CORNER RECORDATION CERTIFICATE

Filing Requirement of Act 74, Mich. P.A. 1970

SECTION

For corners in

Chippewa

(County)

Located In:

Corner Code ##

1. Public Land Survey

T 46N R 1E

L/M-7 #4

T R

T R

T R

2. Property Controlling in Section

S T R

S T R

3. Miscellaneous

S T R

Property in Sec.

S T R

4. Lot No. , Recorded Plat

5. Private Claims

RECEIVED FOR RECORD
CHIPPEWA COUNTY
STATE OF MICHIGAN

93 NOV 31 AM 10:49

J. Roger Malick

REGISTER OF DEEDS

Register of Deeds Stamp & File Number

I, Larry R. Rogers, in a field survey on November 9, 1993

do hereby certify that under requirements of P.A. 74, Michigan P.A. of 1970, the corner points mentioned in lines 1 and 2 above were in conformance with regulations and rules therefore as required in the current manual of survey instructions of the United States Department of the Interior, Bureau of Land Management or by a decree of a Court of Law and/or that the corner points mentioned in lines 3, 4 and 5 above were in conformance with the rules of the Michigan Board of Land Surveyors or by a Decree of a Court of Law; established, re-established, monumented, re-monumented, recovered, found as expressed below:

NOTE: Not more than 4 corners, all in the same town and range, may be recorded on this certificate.

A. Description of original monument and accessories and/or subsequent restoration:

(L/M-7) Meander Corner Between Sections 13 & 24, T46N-R1E

This corner was previously recorded in 1989 by Paul B. Lapham, P.S. 9433, in Liber Page 193 of the Chippewa County Corner Records as a 1/2" x 5' rered with the following witnesses:

| | | |
|----------------------------------|-------|--------|
| 1/2" rered in centerline of road | North | 8.65' |
| 1/2" rered | S80°W | 12.30' |
| Centerline of ditch | South | 17.70' |

B. Description of corner evidence found and/or method applied in restoring or reestablishing corner:


(L/M-7) This corner is being perpetuated as part of the Chippewa County Remonumentation Program.

Recovered 1/2" rered on South edge of gravel road and recovered two rered witnesses from 1989 records. Corner position checks with recovered witnesses. Accepted corner as found and established two new witnesses.

C. Description of monument for corner and accessories established to perpetuate locating the position of the corner:

(L/M-7) Corner is a 1/2" rered on South edge of gravel road (9 Mile Road.)

| | | |
|--|-------|---------|
| Witnesses: Centerline of Ditch | South | 17.70' |
| 1/2" rered in centerline of Road | North | 8.65' |
| 1/2" rered | S80°W | 12.30' |
| 1/2" rered | S86°E | 244.26' |
| Aluminum access cover to Corp of Engineers Triangulation Station | N88°E | 131.67' |

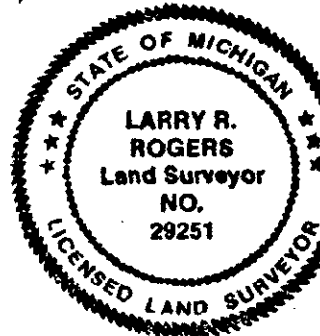

Signed by

Date 11 Nov 1993

Surveyor's Michigan License No. 29251

NOTE: Bearings are compass bearings corrected for declination.

FORM APPROVED BY MICHIGAN STATE BOARD OF LAND SURVEYORS, JAN. 28, 1971
REVISED MAY 14, 1975
REVISED JAN., 1993

L. 8 pg 41

Other code: 4