

SURVEY & REMONUMENTATION

SEP 24 1999

CHIPPEWA COUNTY REMONUMENTATION CORNER

LAND CORNER RECORDATION CERTIFICATE

Filing Requirement of Act 74, Mich. P.A. 1970\$ 7.00 LAND CORNER

SECTION

For corners in

Chippewa

(County)

Located In:

Corner Code #

1. Public Land Survey

T47N R1W

C-10/11

T R

T R

T R

T R

2. Property Controlling in Section

S

T R

S

T R

3. Miscellaneous Property in Sec.

S

T R

S

T R

\$ 2.00 HSSR

28 FEB 96 4:37 P.M.

RECEIPT# 459

RECEIVED FOR RECORD

CHIPPEWA COUNTY - STATE OF MICHIGAN
SHARON H. KENNEDY, REGISTER OF DEEDS

Register of Deeds Stamp & File Number

4. Lot No. , Recorded Plat

5. Private Claims

Keith R. Waters

12/13

95

I, Keith R. Waters, in a field survey on 12/13, 1995 do hereby state that under requirements of P.A. 74, Michigan P.A. of 1970, the corner points mentioned in lines 1 and 2 above were in conformance with regulations and rules therefore as required in the current manual of survey instructions of the United States Department of the Interior, Bureau of Land Management or by a decree of a Court of Law and/or that the corner points mentioned in lines 3, 4 and 5 above were in conformance with the rules of the Michigan Board of Land Surveyors or by a Decree of a Court of Law; established, re-established, monumented, recovered, found as expressed below:

NOTE: Not more than 2 corners, all in the same town and range, may be recorded on this certificate.

	A	B	C	D	E	F	G	H	I	J	K	L
1												
2	6		5		4		3		2		1	
3												
4	7		8		9		10		11		12	
5												
6	18		17		16		15		14		13	
7												
8	19		20		21		22		23		24	
9												
10	30		29		28		27		26		25	
11												
12	31		32		33		34		35		36	
13												

A. Description of original monument and accessories and/or subsequent restoration:

C-10/11 Witness Corner to Meander Corner Between Sections 29 & 30, Town 47 North, Range 1 West

1845 - Original meander corner established by James Mullett 19.10 chains (1260.6 feet) north of Section corner C-11 was a 10" Cedar.

1937 - Rudolph Larsen, Chippewa County Surveyor notes, indicates meander corner at top of clay banks, 1031 feet north of Section corner C-11. Witnesses: 5" Balsam, NORTH 3' - 9" White Birch, N70°W 14'

1977 - Recorded plat of "Sault West", Wayne Boss, R.L.S. 20703, indicates meander corner 995.33 feet north of Section corner C-11. Survey Drawing by Neree D. Alix indicates meander corner 995.33 feet north of Section corner C-11. Bearing of the line between Sections 29 and 30 in relation to the south line of Section 30 checks well with Sault West plat.

1990 - Survey recorded in liber 562, page 402, show 1/2" rod at meander corner, 944.81 feet north of Section corner C-11. Bearings shown are the same as those on the Sault West plat.

B. Description of corner evidence found and/or method applied in restoring or reestablishing corner:

This corner is being perpetuated as part of the Chippewa County Remonumentation Program.

Found a 1/2" iron pin with plastic cap #22428, 944.74 feet north of Section corner C-11, as shown in survey recorded in liber 562, page 402. The bearing of the line between Sections 29 and 30 in relation to the south line of Section 30 checks well with the Sault West plat and the above mentioned Alix survey. Accepted corner location as found and replaced 1/2" iron with a 3/4" rebar and aluminum Chippewa County Remonumentation cap.

C. Description of monument for corner and accessories established to perpetuate locating the position of the corner:

Corner is a 3/4" x 24" rebar with a 3" aluminum Chippewa County Remonumentation cap, approximately 15 feet south of top of the clay banks at the shore of Mosquito Bay. Witnesses:

9" Cedar, N22°E 45.64' (Nail/tag P.S. 33142 in side)

10" Cedar, S81°W 42.41' (Nail/tag P.S. 33142 in side)

12" Cedar, N88°E 10.55' (Nail/tag L.S. 22428 in side)

14" White Birch, S05°W 27.52' (Nail/tag L.S. 22428 in side)



Note: Tress are blazed and painted.

Bearings are compass bearings corrected for declination.

Signed by Keith R. Waters

Date December 29, 1995

Surveyor's Michigan License No. 33142

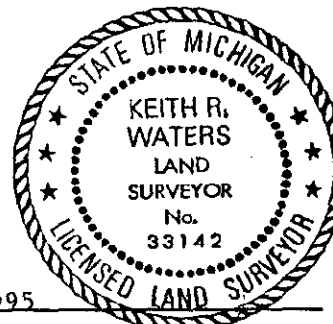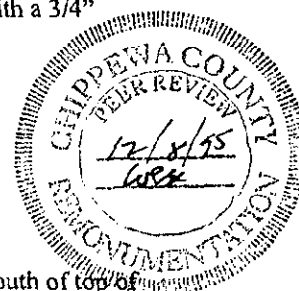

OTHER CODE: 6