

JAN 16 1999

LAND CORNER RECORDATION CERTIFICATE
Filing Requirement of Act 74, Mich. P.A. 1970
Chippewa County Remonumentation Corner

SECTION

For corners in

Chippewa	Located In:	Corner Code #
1. Public Land Survey	SAME CORNER { T 46N R 2E	E/F-1
	T 47N R 2E	E/F-13 ✓
	T R	
	T R	
2. Property Controlling in Section	S T R	# 1
	S T R	
3. Miscellaneous Property in Sec.	S T R	
	S T R	

\$7.00 LAND CORNER
\$2.00 MSSR
21 JAN 1999 10:20:28 AM Receipt #13133
RECEIVED FOR RECORD
CHIPPEWA COUNTY - STATE OF MICHIGAN
SHARON H. KENNEDY, REGISTER OF DEEDS

BOOK 10 PAGE 344
Register of Deeds Stamp & File Number

4. Lot No. _____, Recorded Plat _____
5. Private Claims _____

I, Larry R. Rogers in a field survey on November 5, 1998, do hereby state that under requirements of P.A. 74, Michigan P.A. of 1970, the corner points mentioned in lines 1 and 2 above were in conformance with regulations and rules therefore as required in the current manual of survey instructions of the United States Department of the Interior, Bureau of Land Management or by a decree of a Court of Law and/or that the corner points mentioned in lines 3, 4 and 5 above were in conformance with the rules of the Michigan Board of Land Surveyors or by a Decree of a Court of Law; established, re-established, monumented, recovered, found as expressed below:

NOTE: Not more than 2 corners, all in the same town and range, may be recorded on this certificate.



1	A	B	C	D	E	F	G	H	I	J	K	L	M
2		6		5		4		3		2		1	
3													
4		7		8		9		10		11		12	
5													
6		18		17		16		15		14		13	
7													
8		19		20		21		22		23		24	
9													
10		30		29		28		27		26		25	
11													
12		31		32		33		34		35		36	
13													

A. Description of original monument and accessories and/or subsequent restoration:
(E/F-1) Meander Corner on North Line of Section 4, Township 46 North, Range 2 East.
The original corner was placed in 1845 by John Mullett. County Surveyor Larsen surveyed property both North and South of Township line but made no specific reference to finding or re-establishing the Meander Corner.

B. Description of corner evidence found and/or method applied in restoring or reestablishing corner:
(E/F-1) Meander Corner on North Line of Section 4, Township 46 North, Range 2 East.
This corner is being perpetuated as part of the Chippewa County Remonumentation Program.
Found no evidence of original corner position or subsequent restoration. Re-established corner position by extending the Township line from the North 1/4 Corner of Section 5 through the Northeast corner of Section 5 at the record G.L.O. distance (1155.00 feet) East of the Northeast corner of Section 5. Corner falls 33.0 feet South of and old East-West fence line along the North right-of-way line of Six Mile Road.

C. Description of monument for corner and accessories established to perpetuate locating the position of the corner:
(E/F-1) Meander Corner on North Line of Section 4, Township 46 North, Range 2 East.
Corner is a 3/4" x 24" rebar with stamped aluminum cap set 2" above grade and on the extension of the centerline of an old road bed to West (Six Mile Road).

Witnesses:		
6" Black Ash	N31°W	44.51 feet
12" Black Ash	S88°W	50.51 feet
4" Black Ash	S15°E	14.91 feet
6" Black Ash	S74°E	61.15 feet
East - West Fence Line	North	33.0 feet
Steel Fence Post	North	2.0 feet
Lake George	East	104 feet more or less

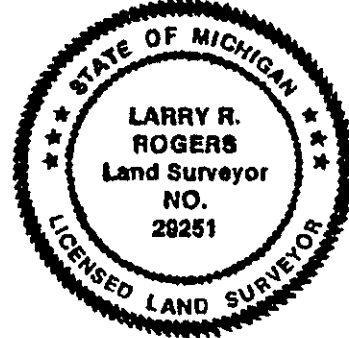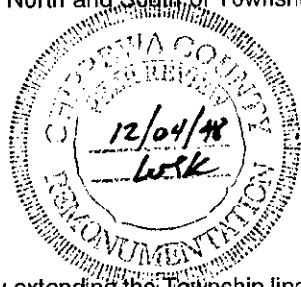

Signed by _____ Date 30 DEC 1998

Surveyor's Michigan License No. 29251
NOTE: All bearings are compass bearings corrected for declination (6°W). All distances are to a nail and tag in the side of witness object unless otherwise noted.