

LAND CORNER RECORDATION CERTIFICATE
Filing Requirement of Act 74, Mich. P.A. 1970
Chippewa County Remonumentation Corner

SECTION

For corners in

Chippewa Located In: Corner Code #

1. Public Land Survey SAME CORNER { T 47N R 2E J/K-1 ✓
T 48N R 2E J/K-13
#4

2. Property Controlling in Section S T R
S T R
S T R

3. Miscellaneous Property in Sec. S T R
S T R

\$7.00 LAND CORNER
\$2.00 MSSR
21 JAN 1999 11:03:17 AM Receipt #13123
RECEIVED FOR RECORD
CHIPPEWA COUNTY - STATE OF MICHIGAN
SHARON H. KENNEDY, REGISTER OF DEEDS

BOOK 10 PAGE 367
Register of Deeds Stamp & File Number

4. Lot No. Recorded Plat
5. Private Claims

I, Larry R. Rogers, in a field survey on November 18, 1998, do hereby state that under requirements of P.A. 74, Michigan P.A. of 1970, the corner points mentioned in lines 1 and 2 above were in conformance with regulations and rules therefore as required in the current manual of survey instructions of the United States Department of the Interior, Bureau of Land Management or by a decree of a Court of Law and/or that the corner points mentioned in lines 3, 4 and 5 above were in conformance with the rules of the Michigan Board of Land Surveyors or by a Decree of a Court of Law; established, re-established, monumented, recovered, found as expressed below:

NOTE: Not more than 2 corners, all in the same town and range, may be recorded on this certificate.

	A	B	C	D	E	F	G	H	I	J	K	L	M
1													
2		6		5		4		3		2		1	
3													
4		7		8		9		10		11		12	
5													
6		18		17		16		15		14		13	
7													
8		19		20		21		22		23		24	
9													
10		30		29		28		27		26		25	
11													
12		31		32		33		34		35		36	
13													


A. Description of original monument and accessories and/or subsequent restoration:
(J/K-1) Meander Corner on North line of Section 2, Township 47 North, Range 2 East.
The original corner was placed in 1842 by John Mullett. Found no reference to corner in County Surveyor notes. In 1996, William L. Karr, P.S. 27450 re-established Meander Corner at record G.L.O. distance East of North 1/4 Corner of Section 2 and on the extension of a line from the Northwest corner of Section 2 through the North 1/4 corner.

B. Description of corner evidence found and/or method applied in restoring or reestablishing corner:
(J/K-1) Meander Corner on North line of Section 2, Township 47 North, Range 2 East.
This corner is being perpetuated as part of the Chippewa County Remonumentation Program.
Found 1/2" x 48" iron with P.S. cap number 27450 set at record G.L.O. (1234.2 feet) East of 1/4 Corner. The North line of Section 2 runs generally along old meandering fence line running East from East Shore Road approximately 600 feet. Accepted Corner position as found.

C. Description of monument for corner and accessories established to perpetuate locating the position of the corner:
(J/K-1) Meander Corner on North line of Section 2, Township 47 North, Range 2 East.
Corner is a 1/2" x 48" iron pin with P.S. cap number 27450 approximately 80 feet West of water's edge of Lake George.

Witnesses:

6" Ash	N46°W	127.90 feet
7" Ash	N45°W	137.50 feet
14" Ash	S75°W	91.60 feet
Wood Post	S76°W	87.7 feet

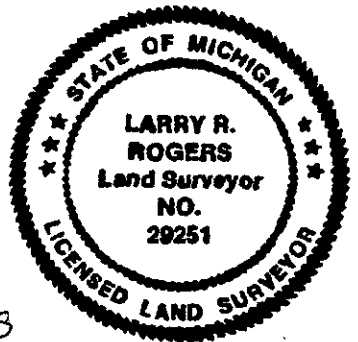

Signed by [Signature] Date 30 DEC 1998

Surveyor's Michigan License No. 29251

NOTE: All bearings are compass bearings corrected for declination (6°W). All distances are to a nail and tag in the side of witness object unless otherwise noted.

FORM APPROVED BY MICHIGAN STATE BOARD OF PROFESSIONAL SURVEYORS, JAN. 28, 1971
REVISED MAY 14, 1975
REVISED JAN., 1983
REVISED OCT., 1995

wp:wpdocs\larry\corner\47nr2e,J/k-1

BOOK 10 PAGE 367