

# SURVEY & REMONUMENTATION

DEC 07 1994

## Chippewa County Remonumentation Corner

### LAND CORNER RECORDATION CERTIFICATE

Filing Requirement of Act 74, Mich. P.A. 1970, 7.00

COMMISSION

For corners in

Chippewa

(County)

Located In:

Corner Code ##

LAND CORNER

\$ 2.00 MSSR

18 OCT 94 1:05 P.M.

RECEIPT# 700

RECEIVED FOR RECORD

CHIPPEWA COUNTY - STATE OF MICHIGAN  
SHARON H. KENNEDY, REGISTER OF DEEDS

1. Public Land Survey T 47N R 2E F-9/G-9  
T \_\_\_\_\_ R \_\_\_\_\_  
T \_\_\_\_\_ R \_\_\_\_\_  
T \_\_\_\_\_ R \_\_\_\_\_
2. Property Controlling S \_\_\_\_\_ T \_\_\_\_\_ R \_\_\_\_\_  
in Section S \_\_\_\_\_ T \_\_\_\_\_ R \_\_\_\_\_
3. Miscellaneous S \_\_\_\_\_ T \_\_\_\_\_ R \_\_\_\_\_  
Property in Sec. S \_\_\_\_\_ T \_\_\_\_\_ R \_\_\_\_\_
4. Lot No. \_\_\_\_\_, Recorded Plat \_\_\_\_\_
5. Private Claims \_\_\_\_\_

Other  
#6

Register of Deeds Stamp & File Number

I, William L. Karr, in a field survey on May 3, 19 93, do hereby certify that under requirements of P.A. 74, Michigan P.A. of 1970, the corner points mentioned in lines 1 and 2 above were in conformance with regulations and rules therefore as required in the current manual of survey instructions of the United States Department of the Interior, Bureau of Land Management or by a decree of a Court of Law and/or that the corner points mentioned in lines 3, 4 and 5 above were in conformance with the rules of the Michigan Board of Land Surveyors or by a Decree of a Court of Law, established, re-established, monumented, re-monumented, recovered, found as expressed below:

**NOTE: Not more than 4 corners, all in the same town and range, may be recorded on this certificate.**

- A. Description of original monument and accessories and/or subsequent restoration:  
(F-9/G-9) Meander Corner Common to Sections 21 & 28 (T47N-R2E)



1845 J.H. Mullett, set post.  
6" Willow N05°W 5 links  
4" Willow S50°W 31 links

- B. Description of corner evidence found and/or method applied in restoring or reestablishing corner:  
(F-9/G-9) This corner is being re-established as part of the Chippewa County Remonumentation Program.

Found no evidence of original corner position. Re-established corner position on line extended through the West 1/16th Corner of Sections 21 & 28 and the North 1/4 Corner of Section 28 at the record GLO distance East of the North 1/4 Corner.

- C. Description of monument for corner and accessories established to perpetuate locating the position of the corner:  
(F-9/G-9) Corner is a 3/4" x 48" iron with 3" diameter aluminum "Chippewa County Remonumentation" cap. Corner falls in marshy area 50' West of water's edge.

Witnesses: North 1/4 Corner of Section 28 N87°W 297.00'  
Power Pole N72°W 172.81'  
10" Ash N65°W 113.13'  
18" Willow S06°E 30.48'

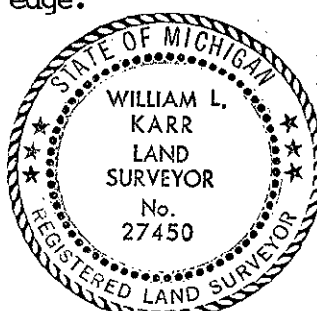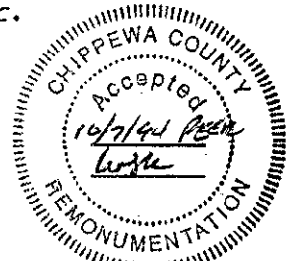

Signed by William L. Karr Date 2/1/94

Surveyor's Michigan License No. 27450

**NOTE: Bearings are compass bearings corrected for declination. Distances are to a nail in side of witness objects unless noted.**