## SURVEY & REMONUMENTATION

FEB 2 3 2001

## LAND CORNER RECORDATION CERTIFICATE Filing Requirement of Act 74, Mich. P.A. 1970

SECTION

Chippewa County Remonumentation Corners 7.00 LAND CORNER

For	corners	in	

Chippewa County	Located in:			Corner Code #
Public Land Survey		T47N T T T	R R R	G-7/G-8 (MC) #009
in Section 3. Miscellaneous	S S S S	T T T T	R R R R	

\$2.00 MSSR 9 FEB 2001 10:49:49 AM Receipt #1201 RECEIVED FOR RECORD CHIPPEWA COUNTY - STATE OF MICHIGAN SHARON H. KENNEDY, REGISTER OF DEEDS

PAGE 246 воок 11

Register of Deeds Stamp & File Number


4. Lot No.

, Recorded Plat

5. Private Claims

I, William L. Karr, P.S., in a field survey on December 8, 2000, do hereby state that under requirements of P.A. 74, Michigan P.A. of 1970, the corner points mentioned in lines 1 and 2 above were in conformance with regulations and rules therefore as required in the current manual of survey instructions of the United States Department of the Interior, Bureau of Land Management or by a decree of a Court of Law and for that the corner points mentioned in lines 3, 4 and 5 above were in conformance with the rules of the Michigan Board of Land Surveyors or by a Decree of a Court of Law; established, re-established, monumented, recovered, found as expressed below:

NOTE: Not more than 2 corners, all in the same town and range, may be recorded on this certificate.

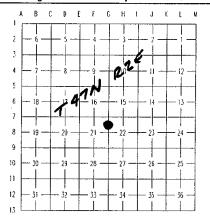

MINIMUM TVA COM

SPERREDO


A. Description of original monument and accessories and/or subsequent restoration: (G-7/G-8) Meander Corner Common to Sections 21 and 22, Township 47 North, Range 2 East.

1845 J. Mullett, D.S. set post.

B. Ash 10 N52W 42

1966 R.H. Larsen notes corner as an angle iron stake 1320 feet South of post.

B. Description of corner evidence found and/or method applied in restoring or reestablishing corner: (G-7/G-8) Meander Corner Common to Sections 21 and 22, Township 47 North, Range 2 East. This corner is being re-established as part of the Chippewa County Remonumentation Program.

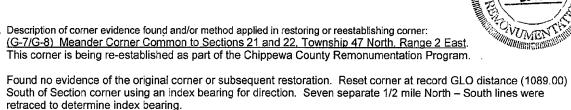

C. Description of monument for corner and accessories established to perpetuate locating the position of the corner: (G-7/G-8) Meander Corner Common to Sections 21 and 22, Township 47 North, Range 2 East.

Corner is a 3/4" x 24" iron with stamped Chippewa County Remonumentation Corner cap on brush line to North.

## Witnesses:

Big Tooth Aspen 12" N07°E 23.70 feet

3/4" witness pipe

with cap Big tooth Aspen 5"

Fast 3.85 feet N26°W 18.15 feet

Water

South

250 feet more or less

Square post

North

4.0 feet

Section corner

15, 16, 21 and 22 North 1089.00 feet

KARR LAND SURYEYOR

Bearings are magnetic compass bearings. All distances are to a nail and tag in the side of the witness object unless otherwise noted.

Signed by

William L. Karr, P.

Surveyor's Michigan License No. 27450

Date 12/29/00

FORM APPROVED BY MICHIGAN STATE BOARD OF PROFESSIONAL SURVEYORS, JAN. 28, 1971 REVISED MAY 14, 1975 REVISED MAY 14, 1975
REVISED JAN., 1983
REVISED OCT., 1995