

FEB 23 2001

SECTION

LAND CORNER RECORDATION CERTIFICATE
Filing Requirement of Act 74, Mich. P.A. 1970
Chippewa County Remonumentation Corner

For corners in

Chippewa County	Located in:	Corner Code #
1. Public Land Survey	T47N R2E	C-2
	T R	
	T R	
	T R	
2. Property Controlling in Section	S T R	
3. Miscellaneous Property in Sec.	S T R	
	S T R	
4. Lot No.	, Recorded Plat	
5. Private Claims		

\$7.00 LAND CORNER

\$2.00 NSSR

9 FEB 2001 10:28:40 AM Receipt #1201
RECEIVED FOR RECORD


CHIPPewa COUNTY - STATE OF MICHIGAN
SHARON H. KENNEDY, REGISTER OF DEEDS

BOOK 11 PAGE 218

Register of Deeds Stamp & File Number

I, Larry R. Rogers, P.S., in a field survey on December 08, 2000, do hereby state that under requirements of P.A. 74, Michigan P.A. of 1970, the corner points mentioned in lines 1 and 2 above were in conformance with regulations and rules therefore as required in the current manual of survey instructions of the United States Department of the Interior, Bureau of Land Management or by a decree of a Court of Law and/or that the corner points mentioned in lines 3, 4 and 5 above were in conformance with the rules of the Michigan Board of Land Surveyors or by a Decree of a Court of Law; established, re-established, monumented, recovered, found as expressed below:

NOTE: Not more than 2 corners, all in the same town and range, may be recorded on this certificate.

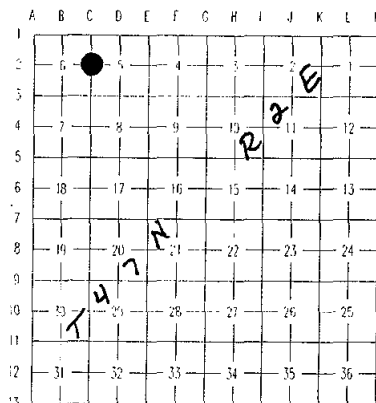

A. Description of original monument and accessories and/or subsequent restoration:
(C-2) 1/4 Corner common to Sections 6 and 5, Township 47 North, Range 2 East.

In 1845 John Mullett set original 1/4 section post and established the following witnesses; 8" Fir N12E 2 lks, 6" Fir S21W 31 lks. 1919 County Surveyor notes refer to a fence to the West of this corner and recite several conflicting distances along the line between Section 5 and 6.

B. Description of corner evidence found and/or method applied in restoring or reestablishing corner:

(C-2) 1/4 Corner common to Sections 6 and 5, Township 47 North, Range 2 East.

This corner is being perpetuated as part of the Chippewa County Remonumentation Program

Found no evidence of original corner or of any subsequent restoration. Placed corner on-line between the Northeast and Southeast corners of Section 6 and on fences to East and West, and established new witnesses.

C. Description of monument for corner and accessories established to perpetuate locating the position of the corner:

(C-2) 1/4 Corner common to Sections 6 and 5, Township 47 North, Range 2 East.

Corner is a 3/4" x 24" iron set in the centerline of Brasser road 0.5 feet below grade with plastic remonumentation cap.

Witnesses:

8" White Spruce	N25°W	101.30 feet
Utility Pole SU1/25B/7	N20°E	282.36 feet
6" White Spruce	S45°E	44.82 feet
4" Aspen	S40°W	53.72 feet


Note: Trees are near residences and are not blazed.

Bearings are magnetic compass bearings. All distances are to a nail and tag in the side of the witness object unless otherwise noted.

Signed by

Larry R. Rogers, P.S.

Surveyor's Michigan License No. 29251

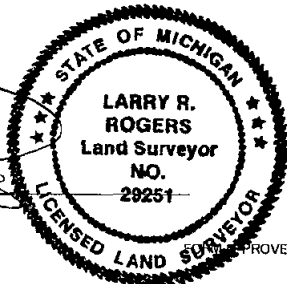

Date

29 DEC 2000