

**SURVEY &  
REMONUMENTATION**

**FEB 23 2001**

**SECTION**

**LAND CORNER RECORDATION CERTIFICATE**  
**Filing Requirement of Act 74, Mich. P.A. 1970**  
**Chippewa County Remonumentation Corner**

For corners in

Chippewa County	Located in:	Corner Code #
1. Public Land Survey	T47N R2E	C-5
	T R	
	T R	
	T R	
2. Property Controlling in Section	S T R	
3. Miscellaneous Property in Sec.	S T R	
	S T R	
4. Lot No.		Recorded Plat
5. Private Claims		

\$7.00 LAND CORNER

\$2.00 MSSR

9 FEB 2001 10:29:41 AM Receipt #1201

RECEIVED FOR RECORD


CHIPPewa COUNTY - STATE OF MICHIGAN

SHARON H. KENNEDY REGISTER OF DEEDS  
BOOK 11 PAGE 221

Register of Deeds Stamp & File Number

I, Larry R. Rogers, P.S., in a field survey on December 01, 2000, do hereby state that under requirements of P.A. 74, Michigan P.A. of 1970, the corner points mentioned in lines 1 and 2 above were in conformance with regulations and rules therefore as required in the current manual of survey instructions of the United States Department of the Interior, Bureau of Land Management or by a decree of a Court of Law and/or that the corner points mentioned in lines 3, 4 and 5 above were in conformance with the rules of the Michigan Board of Land Surveyors or by a Decree of a Court of Law; established, re-established, monumented, recovered, found as expressed below:

NOTE: Not more than 2 corners, all in the same town and range, may be recorded on this certificate.

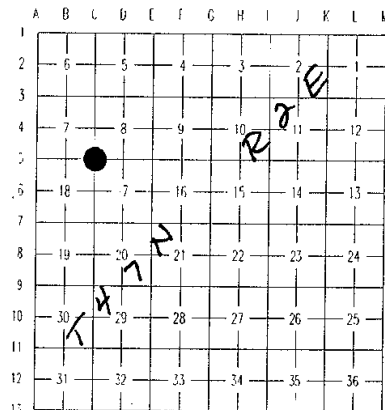

**A. Description of original monument and accessories and/or subsequent restoration:**

(C-5) Section Corner common to Section 7, 8, 17 and 18, Township 47 North, Range 2 East.

Original corner placed in 1845 by John Mullett. No other reference to this corner was found in the County Surveyor records. In 1988, W.L. Karr, P.S. 27450 re-established the corner position by double proportionate measurement using Section corners one mile East, West and South and the 1/4 corner one half mile North. A new LCRC was filed in Liber 7 at Page 104 of the Chippewa County Corner Records.

**B. Description of corner evidence found and/or method applied in restoring or reestablishing corner:**

(C-5) Section Corner common to Section 7, 8, 17 and 18, Township 47 North, Range 2 East.

This corner is being perpetuated as part of the Chippewa County Remonumentation Program.

Found 1/2" iron pin set by Karr and recovered two witnesses from 1988. Accepted corner position as found and established 2 new witnesses.



**C. Description of monument for corner and accessories established to perpetuate locating the position of the corner:**

(C-5) Section Corner common to Section 7, 8, 17 and 18, Township 47 North, Range 2 East.

Corner is a 1/2" iron pin 5" below the surface of Brasser Road (gravel) and 2 feet West of centerline.

Witnesses:

8" Red Maple (existing)	S81°W	106.57 feet
8" W. Spruce (existing)	S71°E	72.25 feet
7" Yellow Birch	N68°W	48.60 feet
6" White Birch	N58°E	58.29 feet



Bearings are magnetic compass bearings. All distances are to a nail and tag in the side of the witness object unless otherwise noted.

Signed by

Larry R. Rogers, P.S.

Surveyor's Michigan License No. 29251

Date

29 DEC 2000