

FEB 23 2001

SECTION

LAND CORNER RECORDATION CERTIFICATE  
Filing Requirement of Act 74, Mich. P.A. 1970  
Chippewa County Remonumentation Corner

For corners in

Chippewa County	Located in:	Corner Code #
1. Public Land Survey	T47N R2E	C-7
	T R	
	T R	
	T R	
2. Property Controlling	S T R	
in Section	S T R	
3. Miscellaneous	S T R	
Property in Sec.	S T R	
4. Lot No.	Recorded Plat	
5. Private Claims		

\$7.00 LAND CORNER

\$2.00 MSSR

9 FEB 2001 10:30:21 AM Receipt #1201


RECEIVED FOR RECORD

CHIPPWEA COUNTY - STATE OF MICHIGAN  
SHARON H. KENNEDY, REGISTER OF DEEDS  
BOOK 11 PAGE 223

Register of Deeds Stamp & File Number

I, Larry R. Rogers, P.S., in a field survey on December 01, 2000, do hereby state that under requirements of P.A. 74, Michigan P.A. of 1970, the corner points mentioned in lines 1 and 2 above were in conformance with regulations and rules therefore as required in the current manual of survey instructions of the United States Department of the Interior, Bureau of Land Management or by a decree of a Court of Law and/or that the corner points mentioned in lines 3, 4 and 5 above were in conformance with the rules of the Michigan Board of Land Surveyors or by a Decree of a Court of Law; established, re-established, monumented, recovered, found as expressed below:

NOTE: Not more than 2 corners, all in the same town and range, may be recorded on this certificate.

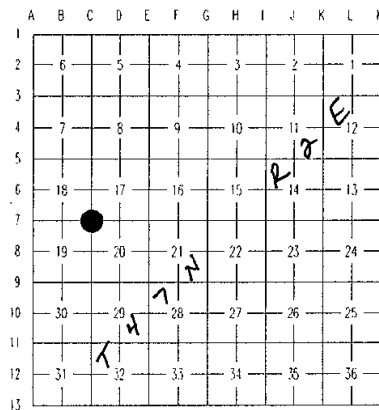

A. Description of original monument and accessories and/or subsequent restoration:

(C-7) Section Corner Common to Sections 17, 18, 19 and 20, Township 47 North, Range 2 East.

The original corner was placed in 1845 by John Mullett. 1930 County Surveyor notes describe corner as a 1" x 30" bolt with three witnesses. In 1976, Neree Alix, P.S. 6254 found bolt and remains of stump that matched position of 1930 witness. Alix filed a new LCRC in Liber 1 at Page 224 of the Chippewa County Corner Records. Corner has since been used by several surveyors and has been referenced as both a bolt and a 1" iron, but the corner position has remained consistent.

B. Description of corner evidence found and/or method applied in restoring or reestablishing corner:

(C-7) Section Corner Common to Sections 17, 18, 19 and 20, Township 47 North, Range 2 East

This corner is being perpetuated as part of the Chippewa County Remonumentation Program.

Found no evidence of the original corner position. Found 1" iron (bolt) from Alix survey but none of the witnesses. Recovered several property irons from other surveys and corner position appears to be unchanged. Accepted corner as found and established four new witnesses.

C. Description of monument for corner and accessories established to perpetuate locating the position of the corner:


(C-7) Section Corner Common to Sections 17, 18, 19 and 20, Township 47 North, Range 2 East.

Corner is a 1" iron (bolt) 4" below surface of gravel road, 6 feet North of the centerline of 3 Mile Road and in the centerline of Brasser Road.

Witnesses:

7" White Birch	S43°E	74.89 feet
12" Maple	N52°E	74.29 feet
Utility Pole (134)	N68°W	103.90 feet
Utility Pole	S61°W	54.39 feet

Bearings are magnetic compass bearings. All distances are to a nail and tag in the side of the witness object unless otherwise noted.

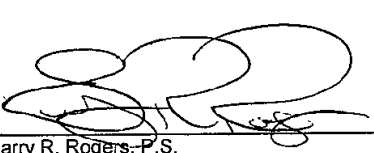Signed by   
Larry R. Rogers, P.S.  
Surveyor's Michigan License No. 29251

Date 29 Dec 2000

