

FEB 23 2001

SECTION

LAND CORNER RECORDATION CERTIFICATE
Filing Requirement of Act 74, Mich. P.A. 1970
 Chippewa County Remonumentation Corner

For corners in

Chippewa County

Located in:

Corner Code #

- | | | | | |
|-------------------------|---|------|-----|-----|
| 1. Public Land Survey | | T47N | R2E | C-8 |
| | | T | R | |
| | | T | R | |
| | | T | R | |
| 2. Property Controlling | S | T | R | |
| in Section | S | T | R | |
| 3. Miscellaneous | S | T | R | |
| Property in Sec. | S | T | R | |

4. Lot No. , Recorded Plat
 5. Private Claims

I, Larry R. Rogers, P.S., in a field survey on December 15, 2000, do hereby state that under requirements of P.A. 74, Michigan P.A. of 1970, the corner points mentioned in lines 1 and 2 above were in conformance with regulations and rules therefore as required in the current manual of survey instructions of the United States Department of the Interior, Bureau of Land Management or by a decree of a Court of Law and/or that the corner points mentioned in lines 3, 4 and 5 above were in conformance with the rules of the Michigan Board of Land Surveyors or by a Decree of a Court of Law; established, re-established, monumented, recovered, found as expressed below:

NOTE: Not more than 2 corners, all in the same town and range, may be recorded on this certificate.

A. Description of original monument and accessories and/or subsequent restoration:

(C-8) 1/4 Corner common to Sections 19 and 20, Township 47 North, Range 2 East.

The original corner post was placed in 1845 by John Mullett. Corner was re-established in 1994 by W.L. Karr, P.S. 27450 on line between the Northeast and Southeast corners of Section 19 and on the extension of a very old fence line to the East.

B. Description of corner evidence found and/or method applied in restoring or reestablishing corner:

(C-8) 1/4 Corner common to Sections 19 and 20, Township 47 North, Range 2 East.

This corner is being perpetuated as part of the Chippewa County Remonumentation Program.

Recovered Karr iron and four witnesses. Accepted corner position as found. Remarkd the four witness objects and placed a new Chippewa County Remonumentation cap on the iron.

C. Description of monument for corner and accessories established to perpetuate locating the position of the corner:

(C-8) 1/4 Corner common to Sections 19 and 20, Township 47 North, Range 2 East.


Corner is a 3/4" iron rebar with Chippewa County Remonumentation cap 6" below grade and 8 feet East of the centerline of Brasser Road (gravel) and on the extension of the remains of an old fence line to the East.

Witnesses:

Utility Pole	N17°E	136.77 feet
Utility Pole	W38°W	52.26 feet
Utility Pole	S17°W	131.29 feet
20" Maple	S86°E	85.66 feet

Bearings are magnetic compass bearings. All distances are to a nail and tag in the side of the witness object unless otherwise noted.

Signed by

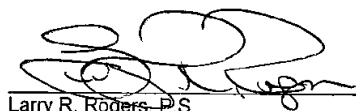

Larry R. Rogers, P.S.

Surveyor's Michigan License No. 29251

Date

29 DEC 2000

\$7.00 LAND CORNER

\$2.00 MSSR

9 FEB 2001 10:30:50 AM Receipt #1201

RECEIVED FOR RECORD

CHIPPEWA COUNTY - STATE OF MICHIGAN

SHARON H. KENNEDY, REGISTER OF DEEDS

BOOK 11 PAGE 224

Register of Deeds Stamp & File Number

