

# SURVEY & REMONUMENTATION

FEB 23 2001

## LAND CORNER RECORDATION CERTIFICATE Filing Requirement of Act 74, Mich. P.A. 1970 Chippewa County Remonumentation Corner

### SECTION For corners in

Chippewa County	Located in:	Corner Code #
1. Public Land Survey	T47N R2E	C-12
	T R	
	T R	
	T R	
2. Property Controlling in Section	S T R	
	S T R	
3. Miscellaneous Property in Sec.	S T R	
	S T R	
4. Lot No. , Recorded Plat		
5. Private Claims		

\$7.00 LAND CORNER

\$2.00 MSSR

9 FEB 2001 10:31:29 AM Receipt #1201

RECEIVED FOR RECORD


CHIPPEWA COUNTY - STATE OF MICHIGAN  
SHARON H. KENNEDY, REGISTER OF DEEDS

BOOK 11 PAGE 226

Register of Deeds Stamp & File Number

I, Larry R. Rogers, P.S., in a field survey on December 15, 2000, do hereby state that under requirements of P.A. 74, Michigan P.A. of 1970, the corner points mentioned in lines 1 and 2 above were in conformance with regulations and rules therefore as required in the current manual of survey instructions of the United States Department of the Interior, Bureau of Land Management or by a decree of a Court of Law and/or that the corner points mentioned in lines 3, 4 and 5 above were in conformance with the rules of the Michigan Board of Land Surveyors or by a Decree of a Court of Law; established, re-established, monumented, recovered, found as expressed below:

NOTE: Not more than 2 corners, all in the same town and range, may be recorded on this certificate.

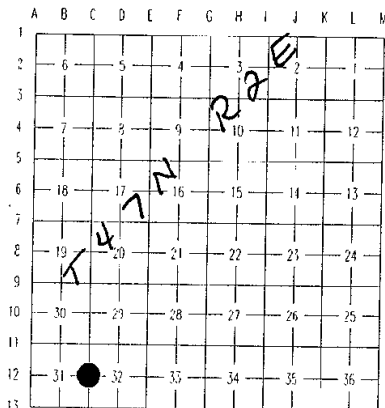

#### A. Description of original monument and accessories and/or subsequent restoration:

(C-12) 1/4 Corner common to Sections 31 and 32, Township 47 North, Range 2 East.

John Mullett set 1/4 section post in 1845 and established the following witnesses: Birch 24 S70E 27 and Sugar 10 S80W 39. In 1981, W.L. Karr, P.S. 27450 found no evidence of original corner and placed a 1/2" x 18" iron with cap number 27450 midway and on line between the Northeast and Southeast corners of Section 31 and recorded a LCRC in Liber 7 at Page 099 of the Chippewa County Corner Records.

#### B. Description of corner evidence found and/or method applied in restoring or reestablishing corner:

(C-12) 1/4 Corner common to Sections 31 and 32, Township 47 North, Range 2 East.

This corner is being perpetuated as part of the Chippewa County Remonumentation Program.

Found 1/2" iron 4" below grade, 3 feet West of centerline of Brasser Road and the bearing trees as previously recorded. Distances to trees match well with record distances. Accepted corner position as found, and established two new bearing trees.

#### C. Description of monument for corner and accessories established to perpetuate locating the position of the corner:

(C-12) 1/4 Corner common to Sections 31 and 32, Township 47 North, Range 2 East.

Corner is a 1/2" iron 4" below grade and 3 feet West of centerline of Brasser Road.

Witnesses:

8" Maple	N44°W	57.99 feet
12" Ash	N60°E	69.44 feet
Utility Pole	S55°E	40.78 feet
12" Maple	S68°W	52.39 feet (previous witness)

Bearings are magnetic compass bearings. All distances are to a nail and tag in the side of the witness object unless otherwise noted.

Signed by

Larry R. Rogers, P.S.

Surveyor's Michigan License No. 29251

Date

29 DEC 2000

FORM APPROVED BY MICHIGAN STATE BOARD OF PROFESSIONAL SURVEYORS, JAN. 28, 1971  
REVISED MAY 14, 1975  
REVISED JAN., 1963  
REVISED OCT., 1995