

FEB 23 2001

SECTION

LAND CORNER RECORDATION CERTIFICATE
Filing Requirement of Act 74, Mich. P.A. 1970
Chippewa County Remonumentation Corner

For corners in

Chippewa County

Located in:

Corner Code #

1. Public Land Survey

T47N R2E E-4

2. Property Controlling
in Section

S

T

R

3. Miscellaneous
Property in Sec.

S

T

R

4. Lot No.

, Recorded Plat

5. Private Claims



\$7.00 LAND CORNER

\$2.00 MSSR

9 FEB 2001 10:33:09 AM Receipt #1201


RECEIVED FOR RECORD

CHIPPWEA COUNTY - STATE OF MICHIGAN

SHARON H. KENNEDY, REGISTER OF DEEDS

BOOK 11 PAGE 232

Register of Deeds Stamp & File Number

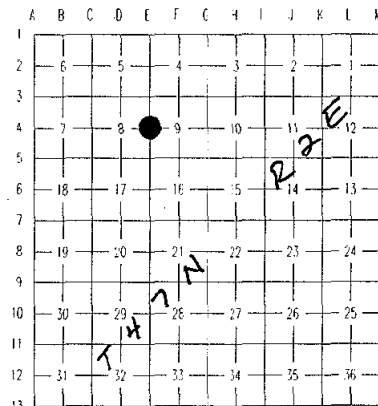

I, Larry R. Rogers, P.S., in a field survey on December 13, 2000, do hereby state that under requirements of P.A. 74, Michigan P.A. of 1970, the corner points mentioned in lines 1 and 2 above were in conformance with regulations and rules therefore as required in the current manual of survey instructions of the United States Department of the Interior, Bureau of Land Management or by a decree of a Court of Law and /or that the corner points mentioned in lines 3, 4 and 5 above were in conformance with the rules of the Michigan Board of Land Surveyors or by a Decree of a Court of Law, established, re-established, monumented, recovered, found as expressed below:

NOTE: Not more than 2 corners, all in the same town and range, may be recorded on this certificate.

A. Description of original monument and accessories and/or subsequent restoration:

(E-4) 1/4 Corner common to Sections 8 and 9, Township 47 North, Range 2 East.

The original corner was placed in 1845 by John Mullett. County Surveyor records of unknown date indicate that the corner is a bolt and cedar post 28 1/2 feet West of the center of a culvert. County Surveyor records dated 1974 indicate that an old cedar post and 3/4" iron were found 2 feet below the surface of a road and that a concrete monument with a brass tablet was placed above the iron and post. In 1985, L.R. Rogers found this concrete monument and used it on a mortgage report and indicated that the distance to the East 1/4 corner of Section 9 is 5120.84 feet and the distance to the Southwest corner of Section 9 is 2694.52 feet.

B. Description of corner evidence found and/or method applied in restoring or reestablishing corner:

(E-4) 1/4 Corner common to Sections 8 and 9, Township 47 North, Range 2 East.

This corner is being perpetuated as part of the Chippewa County Remonumentation Program.

Found a destroyed concrete monument 2 feet, more or less below the existing paved road surface. The corner was replaced over the destroyed monument using the distances as indicated in Rogers' mortgage report. A 6" spike was placed and witnesses were established.

C. Description of monument for corner and accessories established to perpetuate locating the position of the corner:

(E-4) 1/4 Corner common to Sections 8 and 9, Township 47 North, Range 2 East.

Corner is a 6" spike set in asphalt on the edge of a large hole in asphalt 3.0 feet North of centerline of 1 1/2 Mile Road and 2.0 feet West of centerline of Townhall road to South. (Remonumentation iron and monument box to be placed Spring of 2001)

Witnesses:

Utility Pole	N45°W	42.69 feet
Utility Pole SU1/27B/1	N88°E	356.37 feet
10" Spruce	S57°E	125.95 feet
Utility Pole	S13°W	315.54 feet

Bearings are magnetic compass bearings. All distances are to a nail and tag in the side of the witness object unless otherwise noted.

Signed by

Larry R. Rogers, P.S.

Surveyor's Michigan License No. 29251

Date

29 DEC 2000