

FEB 23 2001

LAND CORNER RECORDATION CERTIFICATE

Filing Requirement of Act 74, Mich. P.A. 1970

Chippewa County Remonumentation Corner

\$7.00 LAND CORNER

SECTION

For corners in

Chippewa County

Located in:

Corner Code #

1. Public Land Survey

T47N R2E

E-7

2. Property Controlling
in Section

S

T

R

3. Miscellaneous
Property in Sec.

S

T

R

4. Lot No.

Recorded Plat

5. Private Claims



\$2.00 MSSR

9 FEB 2001 10:33:55 AM Receipt #1201

RECEIVED FOR RECORD


CHIPPewa COUNTY - STATE OF MICHIGAN
SHARON H. KENNEDY, REGISTER OF DEEDS

BOOK 11 PAGE 235

Register of Deeds Stamp & File Number

I, Larry R. Rogers, P.S., in a field survey on December 10, 2000, do hereby state that under requirements of P.A. 74, Michigan P.A. of 1970, the corner points mentioned in lines 1 and 2 above were in conformance with regulations and rules therefore as required in the current manual of survey instructions of the United States Department of the Interior, Bureau of Land Management or by a decree of a Court of Law and/or that the corner points mentioned in lines 3, 4 and 5 above were in conformance with the rules of the Michigan Board of Land Surveyors or by a Decree of a Court of Law; established, re-established, monumented, recovered, found as expressed below:

NOTE: Not more than 2 corners, all in the same town and range, may be recorded on this certificate.

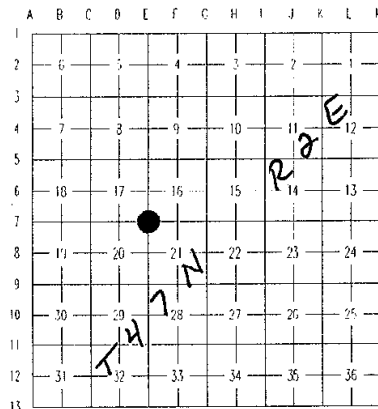

A. Description of original monument and accessories and/or subsequent restoration:

(E-7) Section corner common to Section 16, 17, 20 and 21, Township 47 North, Range 2 East.

Original corner was established by John Mullett in 1845. County Surveyor records of an unknown date describe the corner as a 3 foot bolt with an "old post on N. with bolt in it and new cedar post on South". In 1990, W.L. Karr, P.S. 27450 found the corner as described in the old County Surveyor notes, accepted the corner as found, and filed a L.C.R.C. in Liber 7 at Page 221 of the Chippewa County Corner Records.

B. Description of corner evidence found and/or method applied in restoring or reestablishing corner:

(E-7) Section corner common to Section 16, 17, 20 and 21, Township 47 North, Range 2 East.

This corner is being perpetuated as part of the Chippewa County Remonumentation Program.

Found 1" iron with 1 1/2" flat head (bolt) and three witnesses from Karr survey. Accepted corner position as found and established one new witness object.


C. Description of monument for corner and accessories established to perpetuate locating the position of the corner:

(E-7) Section corner common to Section 16, 17, 20 and 21, Township 47 North, Range 2 East.

Corner is a 1" iron with 1 1/2" flat head (bolt) 0.3 feet below grade on centerline of 3 Mile Road to West and 2.0 feet West of centerline of Townhall road to North and South. Corner falls between two cedar posts buried in the road, North post has a 1" iron in it.

Witnesses:

Utility Pole	N06°W	137.09 feet	(Previous PK nail)
5" Spruce	N39°E	97.99 feet	(New)
Utility Pole SU1/27/64A	S43°E	46.97 feet	(Previous nail)
Utility Pole SU1/27/64	S52°W	45.28 feet	(Previous PK nail)

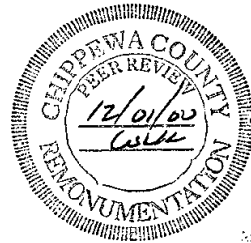

Bearings are magnetic compass bearings. All distances are to a nail and tag in the side of the witness object unless otherwise noted.

Signed by

[Signature]

Larry R. Rogers, P.S.

Surveyor's Michigan License No. 29251

Date

29 DEC 2000