

SURVEY & REMONUMENTATION

FEB 23 2001

LAND CORNER RECORDATION CERTIFICATE

Filing Requirement of Act 74, Mich. P.A. 1970

Chippewa County Remonumentation Corner #7.00 LAND CORNER

For corners in

Chippewa County

Located in:

Corner Code #

- | | | | |
|------------------------------------|---|----------|---------------|
| 1. Public Land Survey | | T47N R2E | G-2 |
| | | T R | |
| | | T R | |
| | | T R | |
| 2. Property Controlling in Section | S | T R | |
| 3. Miscellaneous Property in Sec. | S | T R | |
| | S | T R | |
| 4. Lot No. | | | Recorded Plat |
| 5. Private Claims | | | |

\$2.00 MSSR

9 FEB 2001 10:36:44 AM Receipt #1201

RECEIVED FOR RECORD

CHIPPEWA COUNTY - STATE OF MICHIGAN


SHARON H. KENNEDY, REGISTER OF DEEDS

BOOK 11 PAGE 240

Register of Deeds Stamp & File Number

I, Larry R. Rogers, P.S., in a field survey on December 08, 2000, do hereby state that under requirements of P.A. 74, Michigan P.A. of 1970, the corner points mentioned in lines 1 and 2 above were in conformance with regulations and rules therefore as required in the current manual of survey instructions of the United States Department of the Interior, Bureau of Land Management or by a decree of a Court of Law and/or that the corner points mentioned in lines 3, 4 and 5 above were in conformance with the rules of the Michigan Board of Land Surveyors or by a Decree of a Court of Law; established, re-established, monumented, recovered, found as expressed below:

NOTE: Not more than 2 corners, all in the same town and range, may be recorded on this certificate.

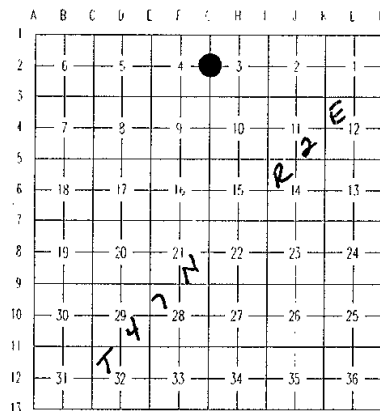

A. Description of original monument and accessories and/or subsequent restoration:

(G-2) 1/4 Corner common to Sections 3 and 4, Township 47 North, Range 2 East.

The original corner post was placed in 1845 by John Mullett. 1917 County Surveyor notes indicate that they measured South from the Northwest corner of Section 3 a distance of 2640 feet, but the notes do not indicate if any corner was placed.

B. Description of corner evidence found and/or method applied in restoring or reestablishing corner:

(G-2) 1/4 Corner common to Sections 3 and 4, Township 47 North, Range 2 East.

This corner is being perpetuated as part of the Chippewa County Remonumentation Program.

Found no evidence of original corner position on any subsequent restoration. Re-established corner position on line and midway between the Northwest and Southwest corners of Section 3. Distances from 1/4 corner to Northwest and Southwest corners of Section 3 are considerably shorter than GLO (GLO = 2640 Measured = 2554.1)

C. Description of monument for corner and accessories established to perpetuate locating the position of the corner:

(G-2) 1/4 Corner common to Sections 3 and 4, Township 47 North, Range 2 East.

Corner is a 3/4" x 24" rebar with stamped aluminum remonumentation cap.

Witnesses:

8" Maple	N06°E	9.95 feet
18" Oak	S56°E	43.71 feet
6" Maple	S16°E	8.21 feet
8" Maple	N73°W	12.35 feet

Bearings are magnetic compass bearings. All distances are to a nail and tag in the side of the witness object unless otherwise noted.


Signed by

Larry R. Rogers, P.S.

Surveyor's Michigan License No. 29251

Date

29 DEC 2000

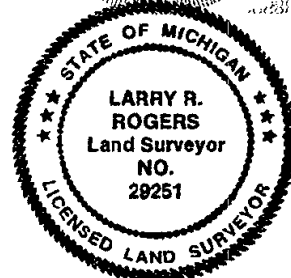

FORM APPROVED BY MICHIGAN STATE BOARD OF PROFESSIONAL SURVEYORS, JAN. 28, 1971
REVISED MAY 14, 1975
REVISED JAN., 1983
REVISED OCT., 1995

BOOK 11 PAGE 240