

FEB 23 2001

LAND CORNER RECORDATION CERTIFICATE
Filing Requirement of Act 74, Mich. P.A. 1970
Chippewa County Remonumentation Corner

SECTION

For corners in

Chippewa County	Located in:	Corner Code #
1. Public Land Survey	T47N R2E	G-4
	T R	
	T R	
	T R	
2. Property Controlling in Section	S T R	
	S T R	
3. Miscellaneous	S T R	
Property in Sec.	S T R	
4. Lot No.	Recorded Plat	
5. Private Claims		

\$7.00 LAND CORNER

\$2.00 MSR


9 FEB 2001 10:48:48 AM Receipt #1201
RECEIVED FOR RECORD
CHIPPewa COUNTY - STATE OF MICHIGAN
SHARON H. KENNEDY, REGISTER OF DEEDS

BOOK 11 PAGE 242

Register of Deeds Stamp & File Number

I, Larry R. Rogers, P.S., in a field survey on January 11, 2000, do hereby state that under requirements of P.A. 74, Michigan P.A. of 1970, the corner points mentioned in lines 1 and 2 above were in conformance with regulations and rules therefore as required in the current manual of survey instructions of the United States Department of the Interior, Bureau of Land Management or by a decree of a Court of Law and /or that the corner points mentioned in lines 3, 4 and 5 above were in conformance with the rules of the Michigan Board of Land Surveyors or by a Decree of a Court of Law; established, re-established, monumented, recovered, found as expressed below:

NOTE: Not more than 2 corners, all in the same town and range, may be recorded on this certificate.

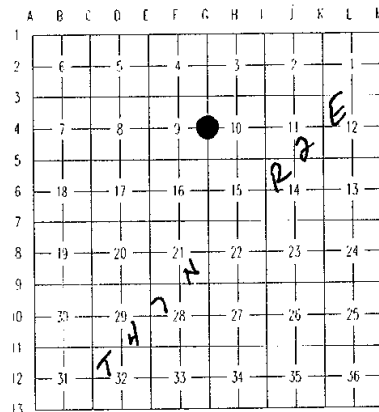

A. Description of original monument and accessories and/or subsequent restoration:

(G-4) 1/4 Corner common to Sections 9 and 10, Township 47 North, Range 2 East.

John Mullett set the original 1/4 section post in 1845. County surveyor records from the 1920's describe the corner as a 1" x 36" bolt with two Maples for witnesses. In 1981 W.L. Karr found one bearing tree and one stump as described in the County Surveyor record's from the 1920's. A 1/2" iron was placed, witnesses established, and a corner was recorded in Liber 5 at Page 074 of the Chippewa County Corner Records.

B. Description of corner evidence found and/or method applied in restoring or reestablishing corner:

(G-4) 1/4 Corner common to Sections 9 and 10, Township 47 North, Range 2 East.

This corner is being perpetuated as part of the Chippewa County Remonumentation Program.

Found a 1/2" iron 1 foot North of centerline of 1 1/2 Mile Road and one witness tree as previously recorded. Accepted corner as found and established three new witnesses.

C. Description of monument for corner and accessories established to perpetuate locating the position of the corner:

(G-4) 1/4 Corner common to Sections 9 and 10, Township 47 North, Range 2 East.

Corner is a 1/2" iron 1 foot North of centerline of 1 1/2 Mile Road.

Witnesses:

Utility Pole	N50°W	58.87 feet	
Utility Pole	N85°E	104.00 feet	
18" Maple	S28°E	39.04 feet	(Previous witness - new tag)
14" Maple	S42°W	36.37 feet	

Bearings are magnetic compass bearings. All distances are to a nail and tag in the side of the witness object unless otherwise noted.

Signed by



Larry R. Rogers, P.S.

Surveyor's Michigan License No. 29251

Date

29 DEC 2000

