

**SURVEY &  
REMONUMENTATION**

**FEB 23 2001**

**LAND CORNER RECORDATION CERTIFICATE**  
**Filing Requirement of Act 74, Mich. P.A. 1970**  
**Chippewa County Remonumentation Corner**

**SECTION**

For corners in

Chippewa County

Located in:

Corner Code #

1. Public Land Survey

T47N R2E I-4

2. Property Controlling  
in Section

S S

T T

R R

3. Miscellaneous  
Property in Sec.

S S

T T

R R

4. Lot No.

, Recorded Plat

5. Private Claims




\$2.00 MSSR

9 FEB 2001 10:51:04 AM Receipt #1201  
RECEIVED FOR RECORD  
CHIPPewa COUNTY - STATE OF MICHIGAN  
SHARON H. KENNEDY, REGISTER OF DEEDS

BOOK 11 PAGE 251

Register of Deeds Stamp & File Number

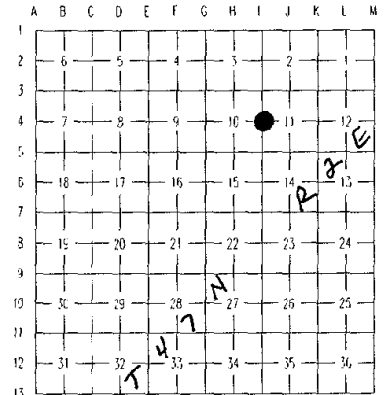

I, Larry R. Rogers, P.S., in a field survey on January 11, 2000, do hereby state that under requirements of P.A. 74, Michigan P.A. of 1970, the corner points mentioned in lines 1 and 2 above were in conformance with regulations and rules therefore as required in the current manual of survey instructions of the United States Department of the Interior, Bureau of Land Management or by a decree of a Court of Law and for that the corner points mentioned in lines 3, 4 and 5 above were in conformance with the rules of the Michigan Board of Land Surveyors or by a Decree of a Court of Law; established, re-established, monumented, recovered, found as expressed below:

NOTE: Not more than 2 corners, all in the same town and range, may be recorded on this certificate.

A. Description of original monument and accessories and/or subsequent restoration:

(I-4) 1/4 Corner common to Sections 10 and 11, Township 47 North, Range 2 East.

John Mullett set original 1/4 section post in 1845. In 1981, a LCRC was recorded in Liber 5 at Page 074 of the Chippewa County Corner Records by W.L. Karr, P.S. 27450 and describes the corner as a found 1" pipe 2 feet above grade with the following witnesses: 10" Aspen N61E 34.92 feet; power pole (SU1/2781/1) S18E 31.84 feet and a power pole S77W 87.08 feet.

B. Description of corner evidence found and/or method applied in restoring or reestablishing corner:

(I-4) 1/4 Corner common to Sections 10 and 11, Township 47 North, Range 2 East.

This corner is being perpetuated as part of the Chippewa County Remonumentation Program.

Recovered 1" pipe and two power pole ties as previously recorded. Accepted corner as found and established two new witness trees.

C. Description of monument for corner and accessories established to perpetuate locating the position of the corner:

(I-4) 1/4 Corner common to Sections 10 and 11, Township 47 North, Range 2 East.

Corner is a 1" pipe 2 feet above grade on approximate extension of centerline of road to West and 55 feet East of centerline of road to North.

Witnesses:

5" Ash	S84°W	11.07 feet
8" Aspen	N55°E	9.74 feet
Utility Pole (SU1/2781/1)	S21°E	31.92 feet (Previous)
Utility Pole	S77°W	87.18 feet (Previous)

Bearings are magnetic compass bearings. All distances are to a nail and tag in the side of the witness object unless otherwise noted.

Signed by

Larry R. Rogers, P.S.

Surveyor's Michigan License No. 29251

Date

29 DEC 2000

FORM APPROVED BY MICHIGAN STATE BOARD OF PROFESSIONAL SURVEYORS, JAN. 28, 1971  
REVISED MAY 14, 1975  
REVISED JAN., 1983  
REVISED OCT., 1995

BOOK 11 PAGE 251